

LINCOLN
 B 37
 9-25-78

MISSISSIPPI
 BOARD OF WATER COMMISSIONERS
 416 North State Street
 Jackson, Mississippi 39201

CODED

WATER WELL DRILLERS LOG

Sept 25 1978 Reynolds Lincoln
 date well completed firm name county well located

LANDOWNER:
Ronald Durr
Rt Brookhaven
 (mailing address)

description of formations encountered	from	to
clay	0	17
bed sand	17	60
blue chalk	60	120
fine sand	120	140
coarse sand	140	152

WELL LOCATION:
 sec. 34 T 8 N R 6 E
9 miles W. NW of Brookhaven
 (distance) (direction) (nearest town)

WELL PURPOSE: Trailer
 (home, irrigation, municipal, industrial)

WELL COMPLETION DATA:

(1) diameter (inches) 4"

(2) total depth (feet) 152'

(3) static water level (feet) 78 below above top of ground.

(4) casing plastic bottom
 (material) (depth)

— If telescope see back.
 (size)

(5) screen 10' 142'
 (length) (depth to top)

4" plastic
 (size) (material)


(6) pump 1/2 hp 10
 (HP) (yield gpm)

shut
 (type power)

(7) electric log no
 (yes or no)

—
 (organization running log)

CODED

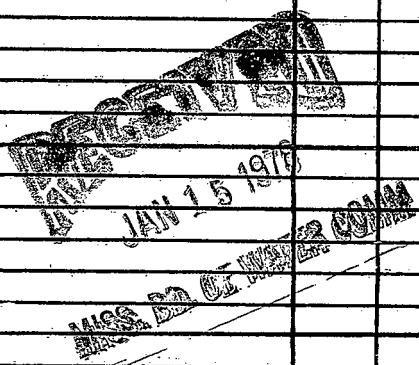


(8) how well bottom plugged wooden plug

DRILLERS REMARKS:
—

If well telescopes please
sketch and show depths.

GROUND LEVEL

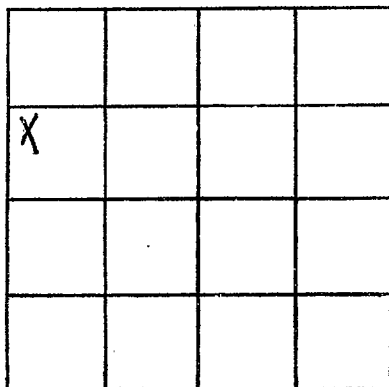

SECTION 34

Please indicate well location X.

ADDITIONAL INFORMATION

If more than one screen,
show locations of each on sketch.