

MISSISSIPPI DEPARTMENT OF NATURAL RESOURCES

Bureau of Land and Water Resources

Southport Mall

P.O. Box 10631

Jackson, Mississippi 39209

WATER WELL DRILLERS LOG

LINCOLN
B 44
4-22-85

April 22

1985 Grenn Water Well

Lincoln

date well completed

firm name

county well located

LANDOWNER: Jerry Smith
Rt. 1, Box 199
Wesson, Ms.
(mailing address)

description of formations encountered	from	to
Citronelle	1	93

WELL LOCATION:
sec. 11 T-8 N R-6 E
S W
8 miles NW of Brookhaven
(distance) (direction) (nearest town)

WELL PURPOSE: home
(home, irrigation, municipal, industrial)

- WELL COMPLETION DATA:
- (1) diameter (inches) 4
 - (2) total depth (feet) 93
 - (3) static water level (feet) 62 below top of ground.
 - (4) casing PVC 73' (material) (depth)
4" (size) If telescope see back.
 - (5) screen 20' 73' (length) (depth to top)
.010 PVC (size) (material)
 - (6) pump 1 hp sub 18 (HP) (yield gpm)
electricity (type power)
 - (7) electric log no (yes or no)
(organization running log)
 - (8) how well bottom plugged back wash valve

RECEIVED

MAY 17 1985

Department of Natural Resources
Bureau of Land & Water Resources


RECEIVED

MAY 17 1985

DRILLERS REMARKS:

If well telescopes please
sketch and show depths.

GROUND LEVEL

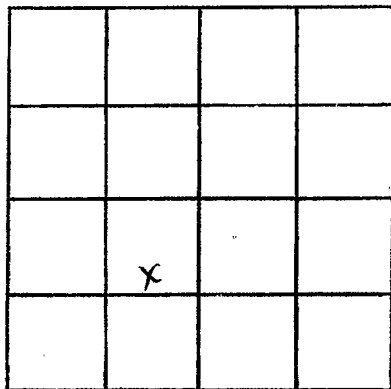

SECTION 11

Please indicate well location X.

ADDITIONAL INFORMATION

If more than one screen,
show locations of each on sketch.