

**MISSISSIPPI DEPARTMENT OF ENVIRONMENTAL QUALITY**

Office of Land and Water Resources

P. O. Box 10631  
Jackson, MS 39289-0631  
**WATER WELL DRILLERS LOG**

COUNTY WELL LOCATED <b>Lincoln</b>	
WELL NUMBER <b>B-57</b>	CODED
DATE WELL COMPLETED <b>6/3/04</b>	

PERMIT NUMBER
NAME OF DRILLING FIRM <b>Green Water Well &amp; Supply, Inc.</b>

NAME & MAILING ADDRESS OF LANDOWNER <b>Etta Mae Berry</b>			
<b>1221 Shadow Ln. N.W., Brookhaven</b>			
Latitude:			
Longitude:			
WELL LOCATION	SEC	TOWNSHIP	RANGE
	<b>1</b>	<b>8</b>	<b>N 6 E</b>
DISTANCE	DIRECTION	NEAREST TOWN	
<b>1</b> Miles	<b>S</b>	<b>of Cold Star</b>	
OTHER LANDMARK			
WELL PURPOSE <input checked="" type="checkbox"/> Home, <input type="checkbox"/> Irrigation, <input type="checkbox"/> Municipal, <input type="checkbox"/> Industrial, <input type="checkbox"/> Fish Pond, etc.			

<b>PUMP DATA</b>			
PUMP TYPE (Circle One): <input checked="" type="checkbox"/> Submersible, <input type="checkbox"/> Turbine, <input type="checkbox"/> Jet, <input type="checkbox"/> Flowing Well, Other (Describe) _____			
POWER TYPE (Circle One): <input checked="" type="checkbox"/> Electric, <input type="checkbox"/> Tractor, <input type="checkbox"/> Diesel, <input type="checkbox"/> Gasoline, <input type="checkbox"/> Butane, Other (Describe) _____ H/P <b>1</b>			

DESCRIPTION OF FORMATIONS ENCOUNTERED	FROM	TO
<b>red clay</b>	<b>0</b>	<b>5</b>
<b>gravel &amp; sand</b>	<b>5</b>	<b>85</b>
<b>blue clay</b>	<b>85</b>	<b>270</b>
<b>sand streaks</b>	<b>270</b>	<b>280</b>
<b>sand</b>	<b>280</b>	<b>300</b>
<b>clay / sand streaks</b>	<b>302</b>	<b>315</b>

**WELL DATA**

Well Depth <b>300</b>	Casing Diameter (In.) <b>4</b>	Casing Length (Ft.) <b>280</b>
Type of Casing <b>PVC</b>	Hole Depth <b>315</b>	Depth to Static Water Level <b>150</b>
TYPE OF COMPLETION: (Circle One or More): <input checked="" type="checkbox"/> Gravel Pack, <input type="checkbox"/> Underreamed, <input type="checkbox"/> Telescoped, <input type="checkbox"/> Natural Development, <input type="checkbox"/> Open Hole, <input type="checkbox"/> Other (Describe) _____		

WELL GROUTED TO A DEPTH OF <b>10</b> FEET
Type Grout (circle one): Cement, Bentonite, or <input checked="" type="checkbox"/> Mix

**SCREEN DATA**

Diameter - Inches <b>4</b>	Length - Feet <b>20</b>	Slot Size - Inches <b>.010</b>
Screen Type <b>PVC</b>	Depth to Bottom - Feet <b>300</b>	

<b>RECEIVED</b>	
<b>JUN 15 2004</b>	
<b>BY: OLWR</b>	
Top of Lap Pipe or Reduction in Casing	
FEET	IF TELESCOPED OR MORE THAN ONE SCREEN: USE BACK PAGE

I certify that the well was drilled, constructed and completed in accordance with all applicable Requirements of the Mississippi Department of Environmental Quality and/or the Mississippi Department of Health regulations and state laws.


**Brian McClelland 664**  
Signature of Licensed Driller and License No.

**6/3/04**  
Date

Additional Information Required On Back

If well telescopes please sketch and show depths.

GROUND LEVEL

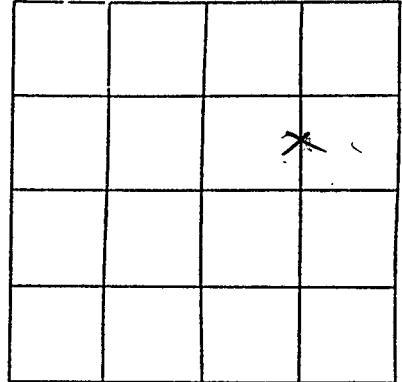

SECTION 1

Please indicate well location X.

Pump Capacity (GPM)	No. of Stages	Setting Depth	
<u>10</u>	<u>15</u>	<u>180</u>	FT.

PUMP TEST

Well yielded 11 GPM with  
a drawdown of 3 ft.  
after 1 hours of pumping

LOG DATA

TYPE OF LOG RUN (Circle One): No Log Run.  
Electric, Gamma Ray, Density, Sonic, Neutron,  
Other (Describe) \_\_\_\_\_

Name of Organization Running Log \_\_\_\_\_

GEOLOGIC DATA (Office Use Only)

Surface Elev.	Geologic Unit	Unit Thickness	Depth to Top
Subs. SWL	Date	Analysis	Aquifer Test

Driller's Remarks

\_\_\_\_\_  
\_\_\_\_\_  
If more than one screen,  
show location of each on sketch.