	¬ STATE	WELL REPORT	
county: Lincoln		Part 1	
Permit #:	Driller's Log Mississippi Department of Environmental Quali Office of Land and Water Resources P.O. Box 2309 Jackson, MS 39225-2309 (601)961-5210		A E
	· ·	1)360-0535 (fax)	
State Law requires that this repor Department at the above address			
Well Owner Informa	tion	Well or Bore	•ho

For Office Use Only:
Well #: <u>B103</u>
Aquifer:
E-Log #:

work and filed with the borehole.

Department at the above dualess within 30 days of con	infiction of ariting of the west or vorenoie.		
Well Owner Information	Well or Borehole Location		
(Landowner if borehole is not for a water well)	Latitude: 31° 41' 49.6" Longitude: 90° 37' 35.4"		
Owner Name: <u>Casey</u> Warren	うら ろら Method of Lat/Long (check one): Conventional Survey		
Mailing Address: <u>IAIFred</u> Rd			
	USGS quad, Hand-held GPS, Survey-grade GPS		
Capequille MS City State Zip Code	NE 14 NW 14, Sec 5 TEN RIE-		
Telephone No. ()	Miles of (Distance) (Direction) (Nearest Town)		
Well / B	orehole Data		
	6/9/14 Hole depth: 95 Hole diameter: 8"		
Location of the source of any surface water used for drilling	· · · · · · · · · · · · · · · · · · ·		
Method of dosing and volume of Chlorine used in drilling ar	1		
Logs run (circle all applicable): No log run Electric Gamm	i i		
Name of organization running log(s):			
Purpose of borehole (circle one): Water Well Geotechnic	cal/Geological Investigation Ground Source Heat Pump		
Seismic Survey Other (describe)		
	onstruction, skip the remainder of this block		
Purpose of Well (circle all applicable): Home Industrial Public Supply Irrigation Fish Culture			
The second of th	JUN 16 20 4		
If a flowing well, method of flow regulation: Valve	Other (describe)		
Static Water Level: 50 feet [above or below] land surface Date measured: 6/9/14			
Method of measurement (circle one): Steel tape Electric ta	ape Air line Other (describe);		
Well depth: 95 Well grouted to a depth of: 10 fe	et Type of grout (circle one): Neat Cement Bentonite Mix		
Casing length: 75 feet Casing diameter:	2.11		
Screen length: 20 feet Screen diameter:	4" inches Type of screen: PVC		
Screen slot size: 0.010 inches Setting depth: From <u>75</u> feet to <u>95</u> feet			
Type of completion (circle all applicable). Gravel packed Underreamed Open hole Natural Development			
Other (describe):			
Top of lap pipe or reduction in casing:feet	e screen, describe on next page		
ij telescopeu of more mun on	e screen, vescrive on next page		

From (depth) To (depth)

96

OLI

(0)

Oh

OLI


(Ja) ਨਾਨ ਨ

06

Ground Level

Description of formations encountered must be provided for ail wells and boreholes, unless specifically exempted by regulations

	If more than one screen, show location of each on sketch	
	•	
purs issum)		
purs		
Seval Charle		
	·	
Description of Formations Encountered		Ground Level
	મુટ <u>અપ્ર સ્કૂલ</u> ાલું	If well telescopes, show dept
wells and boreholes, unless specifica		

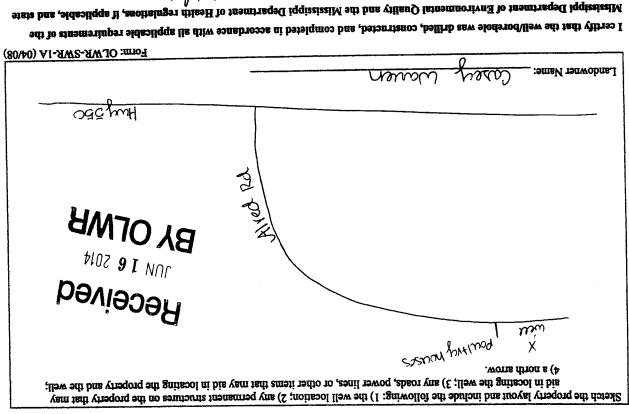

V | 7 V ' Mississippi Department of Environmental Quality and the Mississippi Department of Health regulations, if applicable, and state

Senature of Licensee	Date	e and License No.	Print Name of Responsible License
MANY	1/1-15-0)	かくり	Hans Fall

STATE WELL REPORT

County: Lincoln Permit #: _____ Driller: fitzgerald well Date completed: 6/9/14

Date Well Tested: _____

Static Water Level (A): _____ Feet Below Land Surface

Drawdown [(B) - (A)]: ______Feet Below Land Surface

Method of measurement (circle one): Steel tape Electric tape Air line Other (describe):

Part 2

Pump Installer's Completion Report

Mississippi Department of Environmental Quality
Office of Land and Water Resources
P.O. Box 2309
Jackson, MS 39225-2309
(601)961-5210
(601) 360-0535 (fax)

For O	office Use Only:
Well #: _	B103
Aquifer:	

Duration of Pump Test (minimum 4 hours): _____ hours

Pumping Water Level (B): _____Feet Below Land Surface

Test Pumping Rate: ______Gallons Per Minute

Copy information from block on Part 1 (601) 360-0535 (fax) This part of the report must be completed by a licensed water well contractor or a licensed pump installer. A copy of Part 1 of the report must be attached and both parts filed with the Department at the above address within 30 days of well completion. Well Owner Information Latitude: 31°41'49.6" Longitude: 90°37'35.4" Owner Name: Casey Warun Mailing Address: Al recl Rcl Method of Lat/Long (check one): Conventional Survey___ USGS quad_____, Hand-held GPS_____, Survey-grade GPS_ NE 14 NW 14, Sec 5 TEN R GE Zip Code Telephone No. (Pump Type (circle one) Submersible Turbine Air Lift Centrifugal Flowing Well Jet Piston Rotary Other (describe): _______ Date Pump Installed: _____ 4/9/14 Rated Pump Capacity: _____33 ____ Gallons Per Minute Is This Pump (circle one): (New) Repaired Replacement Power Type (circle one) Electric Diesel Gasoline Natural Gas Tractor PTO Windmill Other (describe): Horse Power Rating of Motor: Setting Depth: _feet Number of Stages: _ Pump Test Data for Non Flowing Well

Pump Test Data fo	or Flowing Well		
Measured shut in head:feet.			
Well yieldedGPM with a drawdown of	feet after	_hours of pumping	
Meter Inst	allation	Doggivad	
Meter Manufacturer:	Meter Serial Number:	Received	
Meter Model Number/Name:	Type of Meter:	JUN 1 6 2014	
Totalizer Register Unit and Multiplier Factor (AF x .001, gal x 10	000, etc):	BY OLWR	
Installation Date: Meter installed by:		DI ULWH	
Is This Meter (circle one): New Repaired Replacement			
Important: By submitting the above information you are certifying that this meter was installed to manufacturer standards. For agricultural wells, a list of approved meters is on the MDEQ website.			

Form: OLWR-SWR-1B (4/13)