

Lincoln
 B 2000
 9-15-75

MISSISSIPPI
 BOARD OF WATER COMMISSIONERS
 416 North State Street
 Jackson, Mississippi 39201

WATER WELL DRILLERS LOG


Sept. 15 19 75 Grenn Water Well Cont. Lincoln
 date well completed firm name county well located

LANDOWNER: <u>Carroll B. Smith</u> <u>Route 3, Box 181</u>	description of fomations encountered <u>Citronelle</u>	from <u>0</u>	to <u>48</u>
<u>Brookhaven, Miss.</u> (mailing address)			
WELL LOCATION: sec. <u>23</u> T <u>8</u> <u>N</u> R. <u>6</u> <u>E</u> ^{14A} <u>9</u> miles <u>NW</u> of <u>Brookhaven</u> (distance) (direction) (nearest town)			
WELL PURPOSE: <u>home</u> (home, irrigation, municipal, industrial)			
WELL COMPLETION DATA: (1) diameter (inches) <u>6</u> (2) total depth (feet) <u>48</u> (3) static water level (feet) <u>35</u> <u>below</u> top of ground. (4) casing <u>PVC</u> , <u>36</u> (material) (depth) <u>4"</u> If telescope see back. (size) (5) screen <u>12'</u> , <u>36'</u> (length) (depth to top) <u>.010</u> <u>PVC</u> (size) (material) (6) pump <u>did not install</u> (HP) (yield gpm) (type power) (7) electric log <u>no</u> (yes or no) (organization running log) (8) how well bottom plugged <u>wood</u>			
DRILLERS REMARKS:			

RECEIVED
 NOV 7 1975
 MISSISSIPPI BOARD OF WATER COMMISSIONERS

If well telescopes please sketch and show depths.

GROUND LEVEL

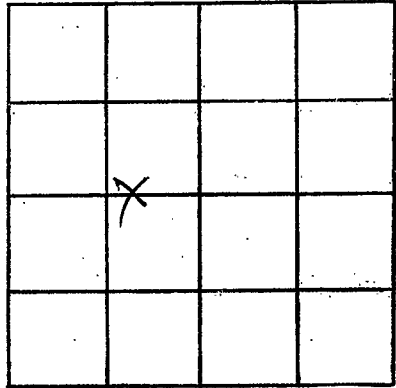

SECTION 23

Please indicate well location X.

ADDITIONAL INFORMATION

If more than one screen, show locations of each on sketch.