

Lincoln
B 2002
7-14-76

MISSISSIPPI
 BOARD OF WATER COMMISSIONERS
 416 North State Street
 Jackson, Mississippi 39201

WATER WELL DRILLERS LOG

July 14 1976 Grenn Water Well Lincoln
 date well completed firm name county well located


LANDOWNER:	description of formations encountered	from	to
Charles Norton	Citronelle	0	88
Route 1, Box 90			
Wesson, Miss.			
(mailing address)			
WELL LOCATION:			
sec. 4 T 8 (N) R 6 (E)			
3 miles NE of Caseyville			
(distance) (direction) (nearest town)			
WELL PURPOSE: home			
(home, irrigation, municipal, industrial)			
WELL COMPLETION DATA:			
(1) diameter (inches) 4			
(2) total depth (feet) 88			
(3) static water level (feet) 63 below top of ground.			
(4) casing PVC 82 (material) (depth)			
4" if telescope see back. (size)			
(5) screen 6' 82 (length) (depth to top)			
.010 PVC (size) (material)			
(6) pump did not install (HP) (yield gpm)			
(type power)			
(7) electric log no (yes or no)			
(organization running log)			
(8) how well bottom plugged			
bask wash valve			
DRILLERS REMARKS:			

RECEIVED

AUG 9 - 1976

If well telescopes please
sketch and show depths.

GROUND LEVEL

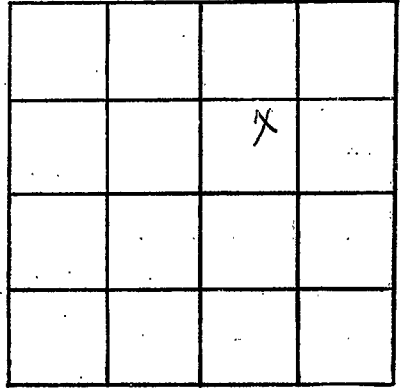

SECTION 4

Please indicate well location X.

ADDITIONAL INFORMATION

If more than one screen,
show locations of each on sketch.