

Lincoln
 B 2003
 9/17/76

MISSISSIPPI
 BOARD OF WATER COMMISSIONERS
 416 North State Street
 Jackson, Mississippi 39201

WATER WELL DRILLERS LOG

17 Sept 1976 ^{14A} J. L. Caraway & Co. Lincoln
 date well completed firm name county well located

LANDOWNER:
 James Smith
 Brookhaven
 (mailing address)

WELL LOCATION:
 sec. 17 T. 8 N R. 6 E
 10 miles NW of Brookhaven
 (distance) (direction) (nearest town)

WELL PURPOSE:
 (home, irrigation, municipal, industrial)

- WELL COMPLETION DATA:
- (1) diameter (inches) ~~4~~ 4
 - (2) total depth (feet) 156
 - (3) static water level (feet) 120 below top of ground.
 - (4) casing (material) PL (depth) 150
 (size) If telescope see back.
 - (5) screen (length) 6 (depth to top) 150
 (size) 4 (material) PL
 - (6) pump (HP) 1/2 (yield gpm) 8
 (type power) plug
 - (7) electric log (yes or no)
 - (organization running log)
 - (8) how well bottom plugged wood

description of formations encountered	from	to
Clay	0	20
Chalk	20	45
Silt	45	65
Chalk	65	90
Sand	90	156


RECEIVED
 OCT 29 1976

DRILLERS REMARKS:

MISS. BD. OF WATER COMMISSIONERS

If well telescopes please sketch and show depths.

GROUND LEVEL

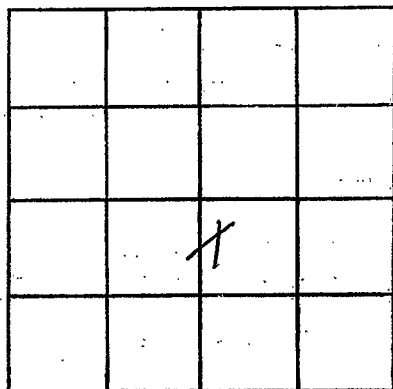

SECTION 12

Please indicate well location X.

ADDITIONAL INFORMATION

If more than one screen, show locations of each on sketch.