

Lincoln  
 B 2006  
 7/15/80

MISSISSIPPI  
 BOARD OF WATER COMMISSIONERS  
 416 North State Street  
 Jackson, Mississippi 39201  
 WATER WELL DRILLERS LOG

July 15 1980 Grenn Water Well Cont. Lincoln  
 date well completed firm name county well located

LANDOWNER: Terry Case Route 1, Box 238	description of fomations encountered Citronelle	from 1	to 170
Wasson, Ms. (mailing address)			
WELL LOCATION: sec 21 T 8 N R 6 E 11 miles NW Brookhaven (distance) (direction) (nearest town)			
WELL PURPOSE: home (home, irrigation, municipal, industrial)			
WELL COMPLETION DATA:			
(1) diameter (inches) 4			
(2) total depth (feet) 170			
(3) static water level (feet) 100 below top of ground.			
(4) casing PVC 160 (material) (depth) 4" if telescope see back. (size)			
(5) screen 10' 160 (length) (depth to top)			
.010 PVC (size) (material)			
(6) pump 3/4 sub 10 (HP) (yield gpm)			
electricity (type power)			
(7) electric log no (yes or no)			
(organization running log)			
(8) how well bottom plugged backwash valve			
DRILLERS REMARKS:			


DEPT. OF NATURAL RESOURCES  
 BUREAU OF LAND & WATER RESOURCES

OCT 23 1980

RECEIVED

If well telescopes please sketch and show depths.

GROUND LEVEL

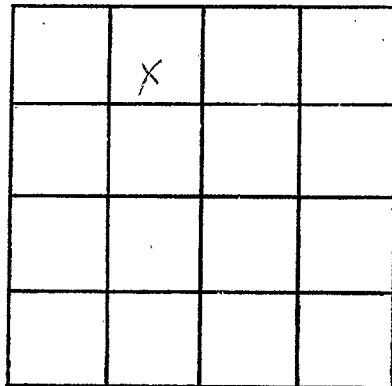

SECTION 21

Please indicate well location X.

ADDITIONAL INFORMATION

If more than one screen, show locations of each on sketch.