

Lincoln  
B 2007  
9-11-80

MISSISSIPPI  
BOARD OF WATER COMMISSIONERS  
416 North State Street  
Jackson, Mississippi 39201

WATER WELL DRILLERS LOG

Sept. 11, 1980 Grenn Water Well Cont. Lincoln  
date well completed firm name county well located

LANDOWNER: <u>Danny Smith</u>	description of formations encountered	from	to
<u>Route 1, Box 89 AA</u> <u>Wesson, Miss.</u> (mailing address)			
WELL LOCATION: sec. <u>4</u> T <u>8</u> <u>N</u> R <u>6</u> <u>E</u> <u>8</u> miles <u>NW</u> of <u>Brookhaven</u> (distance) (direction) (nearest town)			
WELL PURPOSE: <u>home</u> (home, irrigation, municipal, industrial)			
WELL COMPLETION DATA:			
(1) diameter (inches) <u>4</u>			
(2) total depth (feet) <u>153</u>			
(3) static water level (feet) <u>65</u> below above top of ground.			
(4) casing <u>PVC</u> <u>143</u> (material) (depth) <u>4"</u> (size) if telescope see back.			
(5) screen <u>10'</u> <u>143</u> (length) (depth to top) <u>.010</u> <u>PVC</u> (size) (material)			
(6) pump <u>did not install</u> (HP) (yield gpm)  (type power)			
(7) electric log <u>no</u> (yes or no)  (organization running log)			
(8) how well bottom plugged <u>back wash valve</u>			
DRILLERS REMARKS:			


DEPT. OF NATURAL RESOURCES  
BUREAU OF LAND & WATER RESOURCES

OCT 23 1980

RECEIVED

If well telescopes please sketch and show depths.

GROUND LEVEL

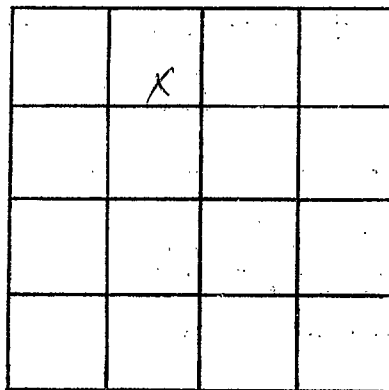

SECTION 4

Please indicate well location X.

ADDITIONAL INFORMATION

If more than one screen, show locations of each on sketch.