

Lincoln  
B 2011  
9-9-81

MISSISSIPPI DEPARTMENT OF NATURAL RESOURCES  
Bureau of Land and Water Resources  
Southport Mall  
P.O. Box 10631  
Jackson, Mississippi 39209  
WATER WELL DRILLERS LOG

Sept. 9 1981 Grenn Water Well Cont. Lincoln  
date well completed firm name county well located

LANDOWNER: A.L. Godbold Route 1 Wesson, Ms. (mailing address)	description of formations encountered Citronelle	from 1	to 190
<b>WELL LOCATION:</b>			
sec. 7 T 8 N R 6 E			
11 miles NW of Brookhaven (distance) (direction) (nearest town)			
<b>WELL PURPOSE:</b> home (home, irrigation, municipal, industrial)			
<b>WELL COMPLETION DATA:</b>			
(1) diameter (inches) 4			
(2) total depth (feet) 190			
(3) static water level (feet) 100 below top of ground.			
(4) casing PVC 180 (material) (depth) 4" if telescope see back. (size)			
(5) screen 10' 180' (length) (depth to top) .010 PVC (size) (material)			
(6) pump 3/4 sub 10 (HP) (yield gpm) electricity (type power)			
(7) electric log no (yes or no)  (organization running log)			
(8) how well bottom plugged back wash valve			

DRILLERS REMARKS:


DEPT. OF NATURAL RESOURCES  
BUREAU OF LAND & WATER RESOURCES

OCT 29 1981

RECEIVED

If well telescopes please  
sketch and show depths.

GROUND LEVEL

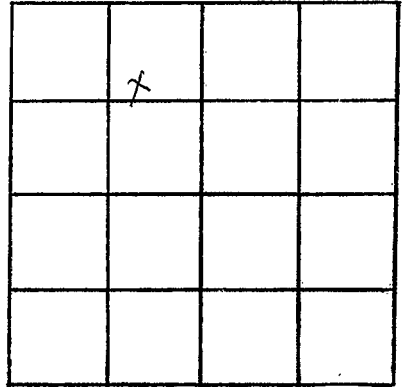

SECTION 7

Please indicate well location X.

ADDITIONAL INFORMATION

If more than one screen,  
show locations of each on sketch.