

Lincoln
B
2013

MISSISSIPPI DEPARTMENT OF NATURAL RESOURCES
 Bureau of Land and Water Resources
 Southport Mall
 P.O. Box 10631
 Jackson, Mississippi 39209
WATER WELL DRILLERS LOG

Apr 14 19 82 Grenn Water Well Lincoln
 date well completed firm name county well located

LANDOWNER:	description of formations encountered	from	to
Charles Mitchell Case Rt. 1, Box 240 Wesson, Ms. (mailing address)	Citronelle	1	160
WELL LOCATION: sec. <u>17</u> T. <u>8</u> N R. <u>6</u> E S W <u>12</u> miles NW of Brookhaven (distance) (direction) (nearest town)			
WELL PURPOSE: home (home, irrigation, municipal, industrial)			
WELL COMPLETION DATA:			
(1) diameter (inches) <u>4</u>			
(2) total depth (feet) <u>160</u>			
(3) static water level (feet) <u>95</u> below top of ground.			
(4) casing <u>PVC</u> , <u>150</u> (material) (depth) <u>4"</u> (size) If telescope see back.			
(5) screen <u>10'</u> , <u>150'</u> (length) (depth to top) <u>.010</u> <u>PVC</u> (size) (material)			
(6) pump <u>3/4</u> sub <u>8</u> (HP) (yield gpm) electricity (type power)			
(7) electric log <u>no</u> (yes or no) (organization running log)			
(8) how well bottom plugged <u>back wash valve</u>			
DRILLERS REMARKS:			


DEPT. OF NATURAL RESOURCES
 BUREAU OF LAND & WATER RESOURCES

JUN 14 1982

RECEIVED

If well telescopes please sketch and show depths.

GROUND LEVEL

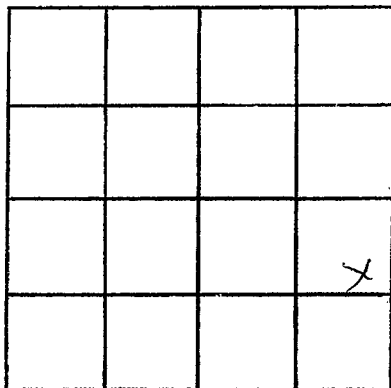

SECTION 17

Please indicate well location X.

ADDITIONAL INFORMATION

If more than one screen,
show locations of each on sketch.