

Lincoln
B
2014

MISSISSIPPI DEPARTMENT OF NATURAL RESOURCES
Bureau of Land and Water Resources
Southport Mall
P.O. Box 10631
Jackson, Mississippi 39209
WATER WELL DRILLERS LOG

May 14 19 82 Grem Water Well Lincoln
date well completed firm name county well located

LANDOWNER:	description of formations encountered	from	to
Ed Tisdale	Citronelle	1	100
P.O. Box 1408			
Brookhaven, Ms.			
(mailing address)			
WELL LOCATION:			
sec. 23 T 8 N R 6 E			
S W			
8 miles NW of Brookhaven			
(distance) (direction) (nearest town)			
WELL PURPOSE: none			
(home, irrigation, municipal, industrial)			
WELL COMPLETION DATA:			
(1) diameter (inches) 4			
(2) total depth (feet) 100			
(3) static water level (feet) 47 below top of ground.			
(4) casing PVC 90			
(material) (depth)			
4" if telescope see back.			
(size)			
(5) screen 10' 90'			
(length) (depth to top)			
.010 PVC			
(size) (material)			
(6) pump 1 sub 20			
(HP) (yield gpm)			
electricity			
(type power)			
(7) electric log no			
(yes or no)			
(organization running log)			
(8) how well bottom plugged			
back wash valve			

DEPT. OF NATURAL RESOURCES
BUREAU OF LAND & WATER RESOURCES


JUN 14 1982

RECEIVED

DRILLERS REMARKS:

If well telescopes please sketch and show depths.

GROUND LEVEL

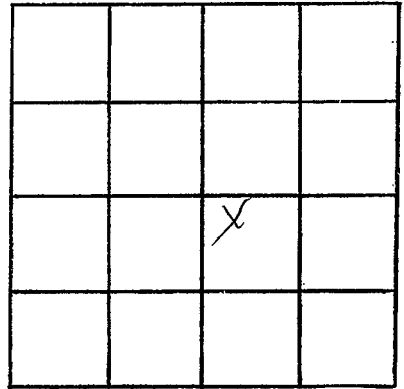

SECTION 23

Please indicate well location X.

ADDITIONAL INFORMATION

If more than one screen,
show locations of each on sketch.