

Lincoln  
B  
2015

MISSISSIPPI  
BOARD OF WATER COMMISSIONERS  
416 North State Street  
Jackson, Mississippi 39201

WATER WELL DRILLERS LOG

5-28

1982

Fitzgerald Well Serv

Lincoln

date well completed

firm name

county well located

LANDOWNER:	description of formations encountered	from	to
Mike Warner R.R. Weston, Jr. (mailing address)	red clay red sand & gravel white blue clay	0 20 60	20 60 130
WELL LOCATION: sec. 5 T 8 N R 6 E S W 5 miles E of Coahoma (distance) (direction) (nearest town)	course sand & gravel	130	140
WELL PURPOSE: (home, irrigation, municipal, industrial)	None		
WELL COMPLETION DATA:			
(1) diameter (inches)	4		
(2) total depth (feet)	140		
(3) static water level (feet)	85 below top of ground.		
(4) casing (material), (depth), (size)	PVC, 132, 4 If telescope see back.		
(5) screen (length), (depth to top), (size), (material)	8, 132, 4, PVC		
(6) pump (HP), (yield gpm), (type power)	1/2, 10, ce		
(7) electric log (yes or no)	no		
(organization running log)			
(8) how well bottom plugged	PVC		
DRILLERS REMARKS:			


DEPT. OF NATURAL RESOURCES  
BUREAU OF LAND & WATER RESOURCES

JUL - 7 1982

RECEIVED

If well telescopes please sketch and show depths.

GROUND LEVEL

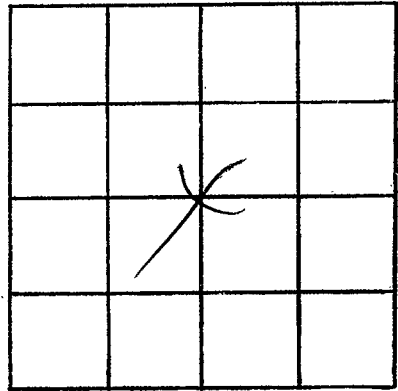

SECTION 5

Please indicate well location X.

ADDITIONAL INFORMATION

If more than one screen,  
show locations of each on sketch.