

Lincoln
B
2017

MISSISSIPPI DEPARTMENT OF NATURAL RESOURCES
Bureau of Land and Water Resources
Southport Mall
P.O. Box 10631
Jackson, Mississippi 39209
WATER WELL DRILLERS LOG

July 28 82 Grenn Water Well Lincoln
date well completed firm name county well located

LANDOWNER: John Cochran, Sr.
Rt. 1, Box 212
Wesson, Ms.
(mailing address)

Description of formations encountered	from	to
clay	1	15
sand & gravel	15	30
white clay	30	70
sand	70	106

WELL LOCATION:
sec. 23 T 8 N R 6 E
S W
8 miles NW of Brookhaven
(distance) (direction) (nearest town)

WELL PURPOSE: home
(home, irrigation, municipal, industrial)

WELL COMPLETION DATA:
(1) diameter (inches) 4
(2) total depth (feet) 106
(3) static water level (feet) 47 below top of ground.
(4) casing P VC, 96',
4" If telescope see back.
(size)
(5) screen 10', 96',
(length) (depth to top)
.010, PVC
(size) (material)
(6) pump 1/2 sub 10
(HP) (yield gpm)
electricity
(type power)
(7) electric log no
(yes or no)
(organization running log)
(8) how well bottom plugged -
back wash valve

DRILLERS REMARKS:


DEPT. OF NATURAL RESOURCES
BUREAU OF LAND & WATER RESOURCES

AUG 23 1982

RECEIVED

If well telescopes please sketch and show depths.

GROUND LEVEL

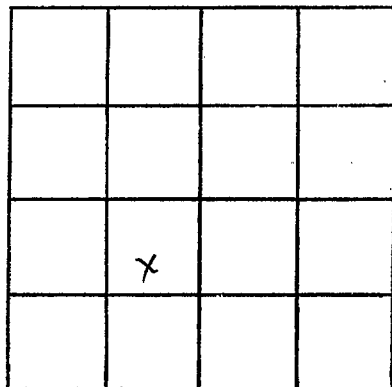

SECTION 23

Please indicate well location X.

ADDITIONAL INFORMATION

If more than one screen,
show locations of each on sketch.