

Lincoln
B
2019

MISSISSIPPI DEPARTMENT OF NATURAL RESOURCES
 Bureau of Land and Water Resources
 Southport Mall
 P.O. Box 10631
 Jackson, Mississippi 39209
WATER WELL DRILLERS LOG

Aug. 3 1982 Grenn Water Well Lincoln
 date well completed firm name county well located

LANDOWNER: Carroll Moak
Rt. 1, Box 285
Caseyville, Ms.
 (mailing address)

description of fomations encountered
Citronelle from 1 to 162

WELL LOCATION:
 sec 6 T 8 N R 6 E
12 miles NW of Brookhaven
 (distance) (direction) (nearest town)

WELL PURPOSE: home
 (home, irrigation, municipal, industrial)

WELL COMPLETION DATA:
 (1) diameter (inches) 4
 (2) total depth (feet) 162
 (3) static water level (feet) 81 below above top of ground.
 (4) casing PVC 152
 (material) (depth)
4" if telescope see back.
 (size)
 (5) screen 10' 152'
 (length) (depth to top)
.010 PVC
 (size) (material)
 (6) pump 1/2 sub 8
 (HP) (yield gpm)
electricity
 (type power)
 (7) electric log no
 (yes or no)
 (organization running log)

(8) how well bottom plugged
back wash valve

DRILLERS REMARKS:


DEPT. OF NATURAL RESOURCES
 BUREAU OF LAND & WATER RESOURCES

NOV 23 1982

RECEIVED

If well telescopes please sketch and show depths.

GROUND LEVEL

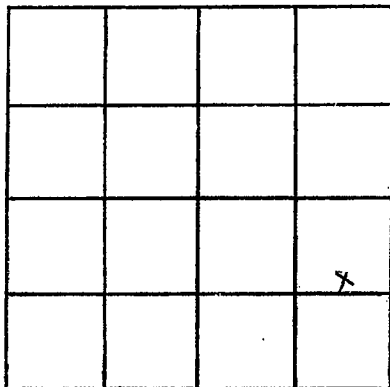

SECTION 6

Please indicate well location X.

ADDITIONAL INFORMATION

If more than one screen,
show locations of each on sketch.