

MISSISSIPPI DEPARTMENT OF NATURAL RESOURCES
 Bureau of Land and Water Resources
 Southport Mall
 P.O. Box 10631
 Jackson, Mississippi 39209
WATER WELL DRILLERS LOG

Lincoln
B
2022

J.M.

4-30 19 84 GREEN LINCOLN
 date well completed firm name county well located

LANDOWNER:
DAVID TYLER
 (mailing address)

description of formations encountered	from	to
	<u>CITRONELLE</u>	<u>0</u>

WELL LOCATION:
 sec. 36 T. 8N. R. 6E.
5 miles WEST of BROOKLAND
 (distance) (direction) (nearest town)

WELL PURPOSE: HOME
 (home, irrigation, municipal, industrial)

- WELL COMPLETION DATA:**
- diameter (inches) 4
 - total depth (feet) 78
 - static water level (feet) 57 below top of ground.
 - casing pvc 68
 (material) (depth)
4 if telescope see back.
 (size)
 - screen 10 68
 (length) (depth to top)
4 pvc
 (size) (material)
 - pump _____ (HP) _____ (yield gpm)
 (type power)
 - electric log no
 (yes or no)
 (organization running log)
 - how well bottom plugged BACKWASH VALVE


DRILLERS REMARKS:

DEPT. OF NATURAL RESOURCES
 BUREAU OF LAND & WATER RESOURCES

JUN 11 1984
RECEIVED

If well telescopes please sketch and show depths.

GROUND LEVEL

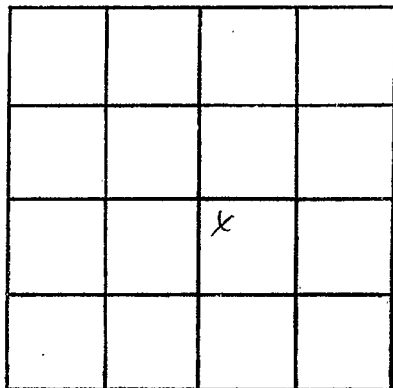

SECTION 36

Please indicate well location X.

ADDITIONAL INFORMATION

Lined area for additional information.

If more than one screen, show locations of each on sketch.