

Lincoln  
B  
7023

MISSISSIPPI DEPARTMENT OF NATURAL RESOURCES  
 Bureau of Land and Water Resources  
 Southport Mall  
 P.O. Box 10631  
 Jackson, Mississippi 39209  
**WATER WELL DRILLERS LOG**

July 13 19 84 Grenn Water Well Lincoln  
 date well completed firm name county well located

LANDOWNER: <u>David James</u>	description of formations encountered	from	to
<u>1285 Caliente Ave.</u>			
<u>Denham Springs, La.</u> (mailing address)	Clay	1	15
	sand & gravel	15	30
	white clay	30	60
	sand	60	100
WELL LOCATION:	white clay	100	130
sec. <u>23</u> T. <u>8</u> N R. <u>6</u> E	blue clay	130	150
S W	white clay	150	165
<u>7</u> miles <u>NE</u> of <u>Brookhaven</u>	Sand	165	272
(distance) (direction) (nearest town)			
WELL PURPOSE: <u>home</u> (home, irrigation, municipal, industrial)			
WELL COMPLETION DATA:			
(1) diameter (inches) <u>4</u>			
(2) total depth (feet) <u>272</u>			
(3) static water level (feet) <u>66</u> below top of ground.			
(4) casing <u>PVC</u> , <u>262</u> (material) (depth)			
<u>4"</u> (size) If telescope see back.			
(5) screen <u>10'</u> , <u>262'</u> (length) (depth to top)			
<u>.010</u> , <u>PVC</u> (size) (material)			
(6) pump <u>did not install</u> (HP) (yield gpm)			
(type power)			
(7) electric log <u>no</u> (yes or no)			
(organization running log)			
(8) how well bottom plugged <u>back wash valve</u>			

DEPT. OF NATURAL RESOURCES  
 BUREAU OF LAND & WATER RESOURCES


SEP 18 1984

RECEIVED

DRILLERS REMARKS:

If well telescopes please sketch and show depths.

GROUND LEVEL

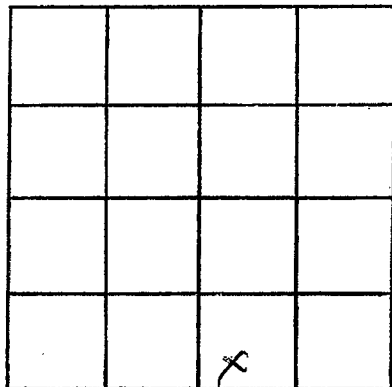

SECTION 23

Please indicate well location X.

ADDITIONAL INFORMATION

If more than one screen,  
show locations of each on sketch.