

Lincoln
B
2024

MISSISSIPPI DEPARTMENT OF NATURAL RESOURCES
 Bureau of Land and Water Resources
 Southport Mall
 P.O. Box 10631
 Jackson, Mississippi 39209
WATER WELL DRILLERS LOG

9-14 1984 Grenn Water Well Lincoln
 date well completed firm name county well located

LANDOWNER: <u>Howard Reeves</u>	description of formations encountered	from	to
<u>Rt. 3, Box 491B</u>	<u>Citronelle</u>	<u>1</u>	<u>72</u>
<u>Brookhaven, Ms.</u> (mailing address)			
WELL LOCATION:			
sec. <u>36</u> T. <u>8</u> N. R. <u>6</u> E S. W.			
<u>5</u> miles <u>NW</u> of <u>Brookhaven</u> , (distance) (direction) (nearest town)			
WELL PURPOSE: <u>home</u> (home, irrigation, municipal, industrial)			
WELL COMPLETION DATA:			
(1) diameter (inches) <u>4</u>			
(2) total depth (feet) <u>72</u>			
(3) static water level (feet) <u>52</u> below top of ground.			
(4) casing <u>PVC</u> , <u>62'</u> (material) (depth) <u>4"</u> (size) if telescope see back.			
(5) screen <u>10'</u> , <u>62'</u> (length) (depth to top) <u>.010</u> <u>PVC</u> (size) (material)			
(6) pump <u>1/2</u> sub <u>8</u> (HP) (yield gpm) <u>electricity</u> (type power)			
(7) electric log <u>no</u> (yes or no)			
<u>(organization running log)</u>			
(8) how well bottom plugged <u>back wash valve</u>			
DRILLERS REMARKS:			


DEPT. OF NATURAL RESOURCES
 BUREAU OF LAND & WATER RESOURCES

NOV 15 1984

RECEIVED

If well telescopes please sketch and show depths.

GROUND LEVEL

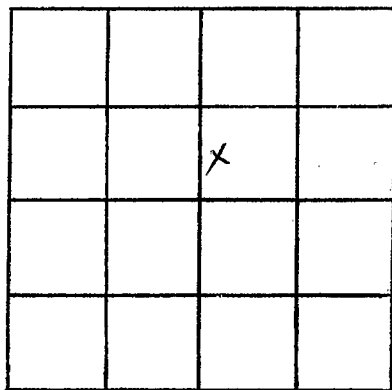

SECTION 36

Please indicate well location X.

ADDITIONAL INFORMATION

If more than one screen,
show locations of each on sketch.