

Lincoln
B
2025

MISSISSIPPI DEPARTMENT OF NATURAL RESOURCES
Bureau of Land and Water Resources
Southport Mall
P.O. Box 10631
Jackson, Mississippi 39209
WATER WELL DRILLERS LOG

9-25 1984 Grenn Water Well Lincoln
date well completed firm name county well located

LANDOWNER:	description of formations encountered	from	to
Jimmy C. Smith	Clay	1	15
54 Fairwood Lane	Sand & Gravel	15	22
Brandon, Ms.	White clay	22	35
(mailing address)	Blue Clay	35	115
WELL LOCATION:	White clay	115	120
sec. 35 T 8 N R 6 E	Sand	120	132
6 miles NW of Brookhaven			
(distance) (direction) (nearest town)			
WELL PURPOSE: home			
(home, irrigation, municipal, industrial)			
WELL COMPLETION DATA:			
(1) diameter (inches) 4			
(2) total depth (feet) 132			
(3) static water level (feet) 55 below above top of ground.			
(4) casing PVC 122' (material) (depth)			
4" (size) if telescope see back.			
(5) screen 10' 122' (length) (depth to top)			
.010 PVC (size) (material)			
(6) pump 1/2 sub 8 (HP) (yield gpm)			
electricity (type power)			
(7) electric log no (yes or no)			
(organization running log)			
(8) how well bottom plugged back wash valve			

DRILLERS REMARKS:


DEPT. OF NATURAL RESOURCES
BUREAU OF LAND & WATER RESOURCES

NOV 15 1984

RECEIVED

If well telescopes please sketch and show depths.

GROUND LEVEL

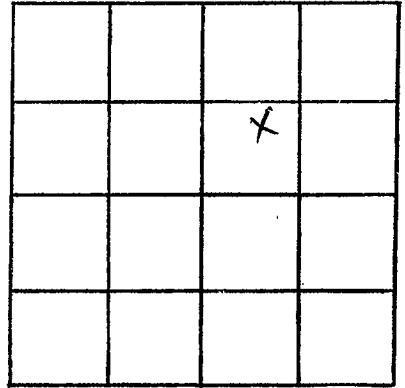

SECTION 35

Please indicate well location X.

ADDITIONAL INFORMATION

If more than one screen,
show locations of each on sketch.