

MISSISSIPPI DEPARTMENT OF NATURAL RESOURCES

Bureau of Land and Water Resources

P.O. Box 10631

Jackson, Mississippi 39209

WATER WELL DRILLERS LOG

COUNTY WELL LOCATED <i>Lincoln</i>	
WELL NUMBER <i>B 2028</i>	CODED
DATE WELL COMPLETED <i>7-30-87</i>	

PERMIT NUMBER
NAME OF DRILLING FIRM <i>Green Water Well Svc</i>

NAME & MAILING ADDRESS OF LANDOWNER <i>D. S. Stillee</i>			
<i>Route 1, Box 259</i>			
<i>Loranger, La.</i>			
WELL LOCATION	SEC	TOWNSHIP	RANGE
	<i>2</i>	<i>8</i>	<i>6</i>
		<i>ND</i>	<i>E</i>
		<i>S</i>	<i>W</i>
DISTANCE	DIRECTION	NEAREST TOWN	
<i>9</i>	<i>NW</i>	<i>Brookhaven</i>	
OTHER LANDMARK			
WELL PURPOSE: Home, Irrigation, Municipal, Industrial, Fish Pond, etc. <i>home</i>			

PUMP DATA		
PUMP TYPE (Circle One): Submersible, Turbine, Jet, Flowing Well, Other (Describe) <i>Did not install</i>		
POWER TYPE (Circle One): Electric, Tractor, Diesel, Gasoline, Butane, Other (Describe)		
Pump Capacity (GPM)	No. of Stages	Setting Depth
		FT.
PUMP TEST		
Well yielded <i>10</i> GPM with a drawdown of <i>0</i> ft. after <i>10 min</i> hours of pumping		

WELL DATA		
Well Depth <i>178</i>	Casing Diameter (In.) <i>4</i>	Casing Length (Ft.) <i>168</i>
Type of Casing <i>PVC</i>	Hole Depth <i>190</i>	Depth to Static Water Level <i>100</i>
TYPE OF COMPLETION: (Circle One or More): <input checked="" type="checkbox"/> Gravel Packed, <input type="checkbox"/> Underreamed, <input type="checkbox"/> Telescoped, <input type="checkbox"/> Natural Development, <input type="checkbox"/> Open Hole, <input type="checkbox"/> Other		
Top of Lap Pipe or Reduction in Casing		
FEET		IF TELESCOPED OR MORE THAN ONE SCREEN: USE BACK PAGE

LOG DATA	
TYPE OF LOG RUN (Circle One): Electric, Gamma Ray, Density, Sonic, Neutron, Other (Describe) <i>No Log Run</i>	
Name of Organization Running Log	

SCREEN DATA		
Diameter - Inches <i>4</i>	Length - Feet <i>10</i>	Slot Size - Inches <i>10/10</i>
Screen Type <i>PVC</i>	Depth to Bottom - Feet <i>178</i>	

GEOLOGIC DATA (Office Use Only)			
Surface Elev.	Geologic Unit	Unit Thickness	Depth to Top
Subs. SWL	Date	Analysis	Aquifer Test

Driller's Remarks

RECEIVED


DESCRIPTION OF FORMATIONS ENCOUNTERED	FROM	TO
<i>Clay</i>	<i>1</i>	<i>20</i>
<i>Sand & Gravel</i>	<i>20</i>	<i>100</i>
<i>White Clay</i>	<i>100</i>	<i>120</i>
<i>Sand</i>	<i>120</i>	<i>190</i>

FORMATIONS (Continued)		FROM	TO
AUG 14 1987			
Department of Natural Resources Bureau of Land & Water Resources			

IF MORE SPACE IS NEEDED, USE BACK

If well telescopes please sketch and show depths.

GROUND LEVEL

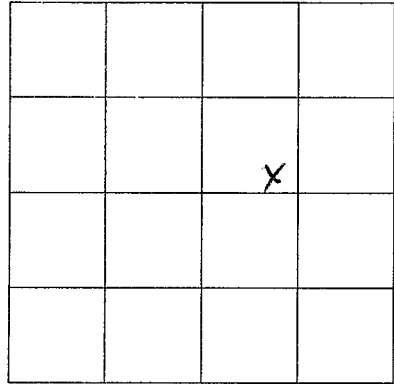

SECTION 2

Please indicate well location X.

ADDITIONAL INFORMATION

If more than one screen,
show location of each on sketch.