

# MISSISSIPPI DEPARTMENT OF NATURAL RESOURCES

Bureau of Land and Water Resources

P.O. Box 10631

Jackson, Mississippi 39209

WATER WELL DRILLERS LOG

COUNTY WELL LOCATED <i>Lincoln</i>	
WELL NUMBER <b>B 2039</b>	CODED
DATE WELL COMPLETED <b>7-17-90</b>	

PERMIT NUMBER
NAME OF DRILLING FIRM <i>Brown Water Well &amp; Supply Inc.</i>

NAME & MAILING ADDRESS OF LANDOWNER <i>Joseph Holcombe</i>			
<i>Rt 7 Box 127 E</i>			
<i>Brookhaven, Miss.</i>			
WELL LOCATION: SEC	TOWNSHIP	RANGE	
<i>30</i>	<i>8</i>	<i>6 W</i>	
DISTANCE	DIRECTION	NEAREST TOWN	
<i>12</i> Miles	<i>NW</i>	of <i>Brookhaven</i>	
OTHER LANDMARK			
WELL PURPOSE <i>(C)</i> Home, Irrigation, Municipal, Industrial, Fish Pond, etc.			

PUMP DATA		
PUMP TYPE (Circle One): <u>Submersible</u> , Turbine, Jet, Flowing Well, Other (Describe) _____		
POWER TYPE (Circle One): <u>Electric</u> , Tractor, Diesel, Gasoline, Butane, Other (Describe) _____ H/P <i>3/4</i>		
Pump Capacity (GPM)	No. of Stages	Setting Depth
<i>10</i>	<i>15</i>	<i>155</i> FT.
PUMP TEST		
Well yielded <i>10</i> GPM with		
a drawdown of <i>2</i> ft.		
after <i>1/2</i> hours of pumping		

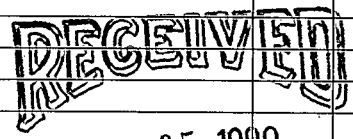
WELL DATA		
Well Depth <i>165</i>	Casing Diameter (In.) <i>4</i>	Casing Length (Ft.) <i>155</i>
Type of Casing <i>PVC</i>	Hole Depth <i>170</i>	Depth to Static Water Level <i>125</i>
TYPE OF COMPLETION: (Circle One or More): <u>Gravel Packed</u> , Underreamed, Telescoped, Natural Development, Open Hole, Other		
Top of Lap Pipe or Reduction in Casing		
FEET <input type="checkbox"/> IF TELESCOPED OR MORE THAN ONE SCREEN: USE BACK PAGE		

LOG DATA	
TYPE OF LOG RUN (Circle One): Electric, Gamma Ray, Density, Sonic, Neutron, Other (Describe) _____	
<u>No Log Run</u>	
Name of Organization Running Log	

SCREEN DATA		
Diameter - Inches <i>4</i>	Length - Feet <i>10</i>	Slot Size - Inches <i>.010</i>
Screen Type <i>PVC</i>	Depth to Bottom - Feet <i>165</i>	

GEOLOGIC DATA (Office Use Only)			
Surface Elev.	Geologic Unit	Unit Thickness	Depth to Top
Subs. SWL	Date	Analysis	Aquifer Test
Driller's Remarks			

DESCRIPTION OF FORMATIONS ENCOUNTERED	FROM	TO
<i>Citronelle</i>	<i>1</i>	<i>90</i>
<i>Clay</i>	<i>90</i>	<i>120</i>
<i>Sand</i>	<i>120</i>	<i>170</i>

FORMATIONS (Continued)	FROM	TO
		
<p style="font-size: 1.5em; margin: 0;">SEP 05 1990</p>		
<p style="font-size: 0.8em; margin: 0;">Department of Natural Resources Bureau of Land &amp; Water Resources</p>		
<p style="font-size: 0.8em; margin: 0;">IF MORE SPACE IS NEEDED, USE BACK</p>		

If well telescopes please  
sketch and show depths.

GROUND LEVEL

		X	

SECTION 20

Please indicate well location X.

ADDITIONAL INFORMATION

If more than one screen,  
show location of each on sketch.