

**MISSISSIPPI DEPARTMENT OF ENVIRONMENTAL QUALITY**  
Bureau of Land and Water Resources

P. O. Box 10631  
Jackson, MS 39289-0631  
**WATER WELL DRILLERS LOG**

COUNTY WELL LOCATED <i>Lincoln</i>	
WELL NUMBER <i>B 2044</i>	CODED
DATE WELL COMPLETED <i>5-20-92</i>	

PERMIT NUMBER
NAME OF DRILLING FIRM <i>Green Water Well &amp; Supply, Inc.</i>

NAME & MAILING ADDRESS OF LANDOWNER <i>Dennis Bowman</i>		
<i>Rt 7 Box 132</i>		
<i>Brookhaven MS</i>		
WELL LOCATION: SEC	TOWNSHIP	RANGE
<i>36</i>	<i>8</i>	<i>N 6 E</i>
DISTANCE	DIRECTION	NEAREST TOWN
<i>7</i> Miles	<i>NN</i>	of <i>Brookhaven</i>
OTHER LANDMARK		
WELL PURPOSE: Home Irrigation, Municipal, Industrial, Fish Pond, etc. <i>(Home)</i>		

PUMP DATA			
PUMP TYPE (Circle One): <input checked="" type="radio"/> Submersible, <input type="radio"/> Turbine, <input type="radio"/> Jet <input type="radio"/> Flowing Well, Other (Describe) _____			
POWER TYPE (Circle One): <input checked="" type="radio"/> Electric, <input type="radio"/> Tractor, <input type="radio"/> Diesel, <input type="radio"/> Gasoline, <input type="radio"/> Butane, Other (Describe) _____ H/P <i>1/2</i>			
Pump Capacity (GPM)	No. of Stages	Setting Depth	
<i>10</i>	<i>9</i>	<i>76</i>	FT.
PUMP TEST			
Well yielded <i>10</i> GPM with a drawdown of <i>1</i> ft. after <i>1</i> hours of pumping			

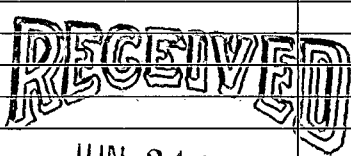
WELL DATA		
Well Depth <i>80</i>	Casing Diameter (In.) <i>4</i>	Casing Length (Ft.) <i>70</i>
Type of Casing <i>PVC</i>	Hole Depth <i>85</i>	Depth to Static Water Level <i>60</i>
TYPE OF COMPLETION: (Circle One or More): <input checked="" type="checkbox"/> Gravel Packed, <input type="checkbox"/> Underreamed, <input type="checkbox"/> Telescoped, <input type="checkbox"/> Natural Development, <input type="checkbox"/> Open Hole, <input type="checkbox"/> Other (Describe) _____		
Top of Lap Pipe or Reduction in Casing		
FEET	IF TELESCOPED OR MORE THAN ONE SCREEN: USE BACK PAGE	

LOG DATA	
TYPE OF LOG RUN (Circle One): <input type="radio"/> Electric, <input type="radio"/> Gamma Ray, <input type="radio"/> Density, <input type="radio"/> Sonic, <input checked="" type="radio"/> No Log Run, <input type="radio"/> Neutron, Other (Describe) _____	
Name of Organization Running Log	

SCREEN DATA		
Diameter - Inches <i>4</i>	Length - Feet <i>10</i>	Slot Size - Inches <i>.010</i>
Screen Type <i>PVC</i>	Depth to Bottom - Feet <i>80</i>	

GEOLOGIC DATA (Office Use Only)			
Surface Elev.	Geologic Unit	Unit Thickness	Depth to Top
Subs. SWL	Date	Analysis	Aquifer Test
Driller's Remarks			

DESCRIPTION OF FORMATIONS ENCOUNTERED	FROM	TO
<i>Clay &amp; Gravel</i>	<i>0</i>	<i>20</i>
<i>Sand &amp; Gravel</i>	<i>20</i>	<i>80</i>
<i>Clay</i>	<i>80</i>	<i>85</i>

FORMATIONS (Continued)	FROM	TO
 JUN 24 1992 Dept. of Environmental Quality Bureau of Land & Water Resources		

IF MORE SPACE IS NEEDED, USE BACK

If well telescopes please  
sketch and show depths.

GROUND LEVEL

		Y	

SECTION 36

Please indicate well location X.

ADDITIONAL INFORMATION

If more than one screen,  
show location of each on sketch.