

**MISSISSIPPI DEPARTMENT OF ENVIRONMENTAL QUALITY**

Office of Land and Water Resources

P. O. Box 10631  
Jackson, MS 39289-0631  
**WATER WELL DRILLERS LOG**

COUNTY WELL LOCATED <i>Seneca</i>	
WELL NUMBER <i>B 2065</i>	CODED
DATE WELL COMPLETED <i>4-30-98</i>	

Green Water Well & Supply 1318 Pricedale Dr. SE Bogalusa, MS 39629
--

NAME & MAILING ADDRESS OF LANDOWNER <i>Melissa Thomas</i>			
<i>2169 Jackson Liberty</i>			
<i>Brookhaven MS</i>			
WELL LOCATION:	SEC	TOWNSHIP	RANGE
	<i>18</i>	<i>8 S</i>	<i>6 E</i>
DISTANCE	DIRECTION	NEAREST TOWN	
<i>2</i> Miles	<i>East</i>	of <i>Caseville</i>	
OTHER LANDMARK			
WELL PURPOSE (Circle One): Home, Irrigation, Municipal, Industrial, Fish Pond, etc.			

PUMP DATA		
PUMP TYPE (Circle One): <input checked="" type="checkbox"/> Submersible, Turbine, Jet, Flowing Well, Other (Describe) _____		
POWER TYPE (Circle One): <input checked="" type="checkbox"/> Electric, Tractor, Diesel, Gasoline, Butane, Other (Describe) _____ H/P <i>3/4</i>		
Pump Capacity (GPM)	No. of Stages	Setting Depth
<i>10</i>	<i>12</i>	<i>140' FT.</i>
PUMP TEST		
Well yielded <i>10</i> GPM with a drawdown of <i>0</i> ft. after <i>1</i> hours of pumping		

WELL DATA		
Well Depth <i>150'</i>	Casing Diameter (In.) <i>4"</i>	Casing Length (Ft.) <i>140'</i>
Type of Casing <i>PVC</i>	Hole Depth <i>161</i>	Depth to Static Water Level <i>108'</i>

TYPE OF COMPLETION: (Circle One or More):  
 Gravel Packed, Underreamed, Telescoped,  
 Natural Development, Open Hole, Other (Describe) \_\_\_\_\_

WELL GROUTED TO A DEPTH OF *10 FEET*  
 Type Grout (circle one): Cement, Bentonite, or  Mix


SCREEN DATA		
Diameter - Inches <i>4"</i>	Length - Feet <i>10'</i>	Slot Size - Inches <i>.010</i>
Screen Type <i>PVC</i>	Depth to Bottom - Feet <i>150'</i>	

LOG DATA	
TYPE OF LOG RUN (Circle One): <input checked="" type="checkbox"/> No Log Run, Electric, Gamma Ray, Density, Sonic, Neutron, Other (Describe) _____	
Name of Organization Running Log	

GEOLOGIC DATA (Office Use Only)			
Surface Elev.	Geologic Unit	Unit Thickness	Depth to Top
Subs. SWL	Date	Analysis	Aquifer Test

Driller's Remarks	
Top of Lap Pipe or Reduction in Casing	
FEET	IF TELESCOPED OR MORE THAN ONE SCREEN: USE BACK PAGE

DESCRIPTION OF FORMATIONS ENCOUNTERED	FROM	TO
<i>Red Clay</i>	<i>0</i>	<i>12</i>
<i>Sand / Gravel Mix</i>	<i>12</i>	<i>161</i>

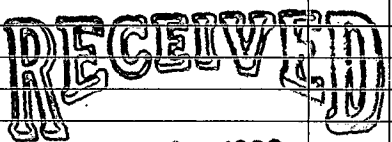FORMATIONS (Continued)	FROM	TO
 JAN 25 1999 Dept. of Environmental Quality Office of Land & Water Resources		

IF MORE SPACE IS NEEDED, USE BACK

If well telescopes please  
sketch and show depths.


GROUND LEVEL

		X	

SECTION 18

Please indicate well location X.

ADDITIONAL INFORMATION

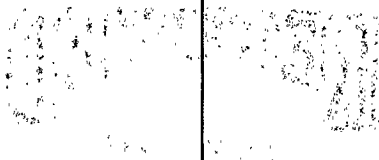

If more than one screen,  
show location of each on sketch.