

6/23

MISSISSIPPI DEPARTMENT OF ENVIRONMENTAL QUALITY

COUNTY WELL LOCATED
Itoneola

WELL NUMBER
B-2075

CODED

DATE WELL COMPLETED
6-25-99

Green Water Well & Supply
1318 Pricedale Dr. SE
Bogue Chitto, MS 39629

Office of Land and Water Resources

P. O. Box 10631
Jackson, MS 39289-0631
WATER WELL DRILLERS LOG

NAME & MAILING ADDRESS OF LANDOWNER
Sonny Bihm
1332 Union St.
Brookhaven

WELL LOCATION: SEC 18 TOWNSHIP 8 RANGE 6
S W

DISTANCE 10 Miles DIRECTION NW of NEAREST TOWN Brookhaven

OTHER LANDMARK

WELL PURPOSE: Home Irrigation, Municipal, Industrial, Fish Pond, etc.

PUMP DATA

PUMP TYPE (Circle One):
Submersible, Turbine, Jet, Flowing Well,
Other (Describe)

POWER TYPE (Circle One):
Electric, Tractor, Diesel, Gasoline, Butane,
Other (Describe) H/P 1

Pump Capacity (GPM) 16 No. of Stages 10 Setting Depth 130' FT.

PUMP TEST
Well yielded 15 GPM with
a drawdown of 5 ft.
after 1 hours of pumping

WELL DATA

Well Depth 170' Casing Diameter (In.) 4" Casing Length (Ft.) 160'

Type of Casing PVC Hole Depth 180' Depth to Static Water Level 93'

LOG DATA

TYPE OF LOG RUN (Circle One): No Log Run,
Electric, Gamma Ray, Density, Sonic, Neutron,
Other (Describe)

Name of Organization Running Log

TYPE OF COMPLETION: (Circle One or More):
Gravel-Packed, Underreamed, Telescoped,
Natural Development, Open Hole, Other
(Describe)

GEOLOGIC DATA (Office Use Only)

Surface Elev.	Geologic Unit	Unit Thickness	Depth to Top
Subs. SWL	Date	Analysis	Aquifer Test

WELL GROUTED TO A DEPTH OF 10 FEET
Type Grout (circle one): Cement, Bentonite, or Mix

Driller's Remarks

RECEIVED

Top of Cap Pipe or Reduction in Casing

FEET IF TELESCOPED OR MORE THAN ONE SCREEN: USE BACK PAGE

SCREEN DATA

Diameter - Inches 4" Length - Feet 10' Slot Size - Inches .010


Screen Type PVC Depth to Bottom - Feet 170'

DESCRIPTION OF FORMATIONS ENCOUNTERED	FROM	TO	FORMATIONS (Continued)	FROM	TO
<u>Red Clay</u>	<u>0</u>	<u>5</u>	<u>Dept. of Environmental Quality Office of Land & Water Resources</u>		
<u>Gravel</u>	<u>5</u>	<u>20</u>			
<u>Sand</u>	<u>20</u>	<u>55</u>			
<u>Sand/Gravel</u>	<u>55</u>	<u>180</u>			

IF MORE SPACE IS NEEDED, USE BACK

If well telescopes please
sketch and show depths.

GROUND LEVEL

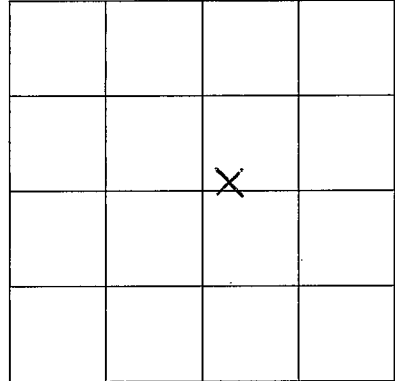

SECTION 18

Please indicate well location X.

ADDITIONAL INFORMATION

Lined area for additional information.

If more than one screen,
show location of each on sketch.