

MISSISSIPPI DEPARTMENT OF ENVIRONMENTAL QUALITY

Office of Land and Water Resources

P. O. Box 10631

Jackson, MS 39289-0631

WATER WELL DRILLERS LOG

COUNTY WELL LOCATED  
Lincoln

WELL NUMBER CODED  
B-2088

DATE WELL COMPLETED  
5/24/02

PERMIT NUMBER

NAME OF DRILLING FIRM  
Green Water Well & Supply, Inc.

NAME & MAILING ADDRESS OF LANDOWNER  
Dusty Case

3066 Hwy 550 Wesson

Latitude:  
Longitude:

WELL LOCATION: SEC 17 TOWNSHIP 8 RANGE 6  N  S  E  W

DISTANCE DIRECTION NEAREST TOWN  
12 Miles NW of Brookhaven

OTHER LANDMARK

WELL PURPOSE: Home  (Irrigation) Municipal, Industrial, Fish Pond, etc.

PUMP DATA

PUMP TYPE (Circle One):  
 Submersible Turbine, Jet, Flowing Well,  
Other (Describe)

POWER TYPE (Circle One):  
 Electric, Tractor, Diesel, Gasoline, Butane,  
Other (Describe) H/P 3

DESCRIPTION OF FORMATIONS ENCOUNTERED	FROM	TO
<u>streaky-clay, sand gravel</u>	<u>0</u>	<u>85</u>
<u>sand &amp; gravel</u>	<u>85</u>	<u>240</u>

RECEIVED  
JUN 17 2002  
BY: OLWR

Top of Lap Pipe or Reduction in Casing

FEET IF TELESCOPED OR MORE THAN ONE SCREEN: USE BACK PAGE

WELL DATA

Well Depth <u>230'</u>	Casing Diameter (In.) <u>4"</u>	Casing Length (Ft.) <u>200'</u>
Type of Casing <u>PVC</u>	Hole Depth <u>240'</u>	Depth to Static Water Level <u>105'</u>
TYPE OF COMPLETION: (Circle One or More): <input checked="" type="radio"/> Gravel Packed <input type="radio"/> Underreamed, <input type="radio"/> Telescoped, <input type="radio"/> Natural Development, <input type="radio"/> Open Hole, <input type="radio"/> Other (Describe)		
WELL GROUTED TO A DEPTH OF <u>10</u> FEET Type Grout (circle one): Cement, Bentonite, or <input checked="" type="radio"/> Mix		

SCREEN DATA

Diameter - Inches <u>4"</u>	Length - Feet <u>30'</u>	Slot Size - Inches <u>.010</u>
Screen Type <u>PVC</u>	Depth to Bottom - Feet <u>230'</u>	

I certify that the well was drilled, constructed and completed in accordance with all applicable Requirements of the Mississippi Department of Environmental Quality and/or the Mississippi Department of Health regulations and state laws.

Brian McClelland 0664  
Signature of Licensed Driller and License No.


5/24/02

Date

Additional Information Required On Back

If well telescopes please sketch and show depths.

GROUND LEVEL

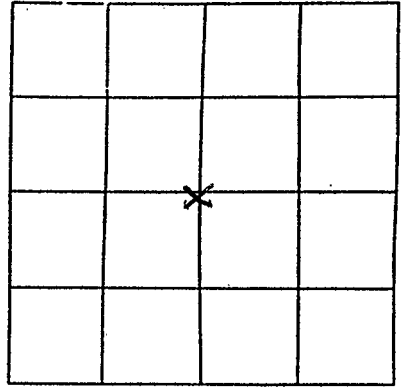

SECTION 17

Please indicate well location X.

Pump Capacity (GPM)	No. of Stages	Setting Depth
<u>40</u>	<u>15</u>	<u>150</u> FT.
PUMP TEST		
Well yielded <u>34</u> GPM with		
a drawdown of <u>3</u> ft.		
after <u>1</u> hours of pumping		

LOG DATA

TYPE OF LOG RUN (Circle One):	No Log Run, Electric, Gamma Ray, Density, Sonic, Neutron, Other (Describe)
Name of Organization Running Log	

GEOLOGIC DATA (Office Use Only)

Surface Elev.	Geologic Unit	Unit Thickness	Depth to Top
Subs. SWL	Date	Analysis	Aquifer Test

Driller's Remarks

If more than one screen, show location of each on sketch.