

C1

CODED

WATER WELL DRILLERS LOG

6-13-63

Date: June 13, 1963, Driller: E. B. Jones County: Leflore

(Name)

(1) Owner of Land:	Description & Color of Materials Sand, Clay, Red Clay, Shell, etc.	Thick- ness Feet	Depth Feet
<u>W. H. P. Smith</u> (Name)	<u>Brown cl</u>	<u>0</u>	<u>8</u>
<u>Rt. 6, Box 1980, B. Brown, Mo.</u> (Address)	<u>Brown sh cl</u>	<u>8</u>	<u>12</u>
(2) Location: <u>SE 1/4, NW 1/4, Sec 27, T 8 R 7</u>	<u>Rock</u>	<u>12</u>	<u>14</u>
<u>4</u> miles <u>NW</u> of <u>Phoen</u> (distance) (direction) (Nearest Town)	<u>Sh & gravel</u>	<u>14</u>	<u>80</u>
(3) Topography: <u>the flat</u> (Hilly) (Flat) (Level)			
(4) Purpose of Well: <u>Domestic</u> (Domestic Irrigation Municipal, Industrial, Other)			

Information upon completion of well:


- (1) Diameter 6" inches.
- (2) Total Depth 80' feet.
- (3) Water Level 50' feet below top of ground.
- (4) Cased to 80', Size 4"
- (5) Screen: Size 08, Length 8'
- (6) Were any formations sealed against pollution?
_____ yes, no.

If YES depth of formation _____

Why _____

Drillers Remarks: _____

CODED

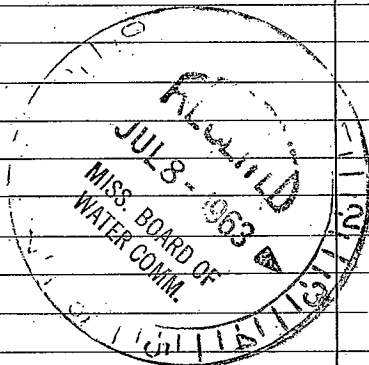

(Use Back Side)

Well No.

