

LINCOLN

MISSISSIPPI BOARD OF WATER COMMISSIONERS

C2

3-16-65 CODED WATER WELL DRILLERS LOG

Date: 3-16, 1965, Driller: Chester Reeves County Lincoln
(Name)

(1) Owner of Land:	Description & Color of Materials Sand, Clay, Red Clay, Shell, etc.	Thick- ness Feet	Depth Feet
Wayne Williams (Name) Brookhaven (Address)	Surface clay yellow sandy clay	15	15
(2) Location: 1/4, 1/4, Sec. 13 T8 R7, 7 miles NW of Brookhaven (distance) (direction) (Nearest Town)	Blue clay	30	45
(3) Topography: Hilly (Hilly) (Flat) (Level)	Blue clay	315	360
(4) Purpose of Well: Domestic (Domestic Irrigation Municipal, Industrial, Other)	fine white sand	50	410

Information upon completion of well:

- (1) Diameter: 2 inches.
- (2) Total Depth: 410 feet.
- (3) Water Level: 69 feet below top of ground.
- (4) Cased to bottom, Size 2"
- (5) Screen: Size 1/4", Length 5'
- (6) Were any formations sealed against pollution?
yes, no.


If YES depth of formation _____

Why _____

Drillers Remarks: old shallow well no good

CODED

REEVES WELL & PUMP CO.
P. O. BOX 971 - PHONE 684-1251
McCOMB, MISS.

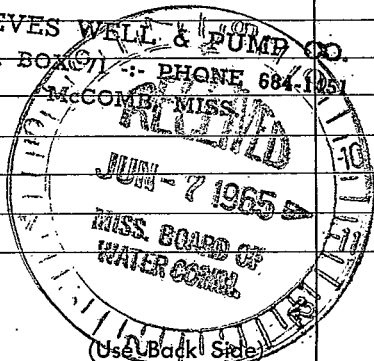

Well No.

1870

1871

1872

1873