

LINCOLN
C 6
10-19-63

WATER WELL DRILLERS LOG

OK'd
CODED

Date: 10/19/63, 1963, Driller: Roy Chandler Jr County: Lincoln
(Name)

(1) Owner of Land: Willie M. Smith
(Name)
R.F.D. #1 BRANCH AVE N. W. M.
(Address)

(2) Location: $\frac{1}{4}$, $\frac{1}{4}$, Sec. 6 T 8 N R 7
Largest liquor dealer
miles of
(distance) (direction) (Nearest Town)
Lincoln County

(3) Topography: WELL KNOWN
(Hilly) (Flat) (Level)

(4) Purpose of Well: Dwelling
(Domestic Irrigation, Municipal, Industrial, Other)

Description & Color of Materials Sand, Clay, Red Clay, Shell, etc.	Thick- ness Feet	Depth Feet
<u>yellow clay</u>	<u>3</u>	<u>3</u>
<u>Clay & S. gravel</u>	<u>60</u>	<u>60</u>
<u>Coarse rock fine</u>		
<u>Rock coarse</u>	<u>12</u>	<u>12</u>
<u>Sand</u>		

Information upon completion of well:

(1) Diameter 16 inches.

(2) Total Depth 75 feet.

(3) Water Level 63' feet below top of ground.


(4) Cased to 75', Size 8"

(5) Screen: Size NONE, Length —

(6) Were any formations sealed against pollution?
all joints, asphalt sealed
Cemented top of tile 18"
Yes, no. DOWN

If YES depth of formation _____
Why Keep out surface water

Drillers Remarks: _____

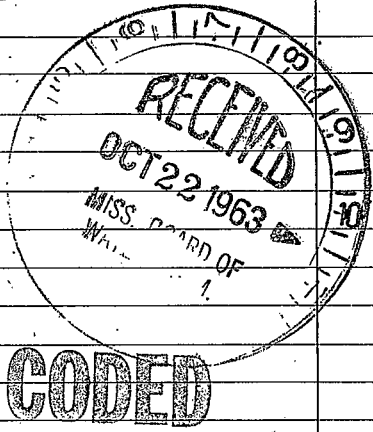

100