

**CODED**

LINCOLN

C-7

7-15-71

MISSISSIPPI  
BOARD OF WATER COMMISSIONERS  
416 North State Street  
Jackson, Mississippi 39201

WATER WELL DRILLERS LOG

**CODED**

July 15 19 71 Grenn Water Well Contractor Lincoln  
date well completed firm name county well located

LANDOWNER: <u>Lessie Touchstone</u> <u>Field Lark Lane</u> <u>Brookhaven, Miss.</u> (mailing address)	description of formations encountered	from	to
	<u>Citronelle</u>	<u>0</u>	<u>100</u>
<b>WELL LOCATION:</b>			
sec. <u>36</u> T <u>8</u> N R <u>7</u> E			
S W			
<u>1</u> miles <u>NW</u> of <u>Brookhaven</u>			
(distance) (direction) (nearest town)			
<b>WELL PURPOSE:</b> <u>home</u> (home, irrigation, municipal, industrial)			
<b>WELL COMPLETION DATA:</b>			
(1) diameter (inches) <u>6"</u>			
(2) total depth (feet) <u>100</u>			
(3) static water level (feet) <u>45</u> below above top of ground.			
(4) casing <u>PVC</u> <u>79</u> (material) (depth)			
<u>4"</u> if telescope see back. (size)			
(5) screen <u>6'</u> <u>79</u> (length) (depth to top)			
<u>.010</u> <u>PVC</u> (size) (material)			
(6) pump <u>1/3</u> sub. <u>7</u> (HP) (yield gpm)			
<u>electric</u> (type power)			
(7) electric log <u>no</u> (yes or no)			
<u>(organization running log)</u>			
(8) how well bottom plugged <u>wood</u>			
<b>DRILLERS REMARKS:</b>			


**CODED**

AUG 17 1971

MISS. DD. 05  
REVISED 1968  
MISSISSIPPI BOARD OF WATER COMMISSIONERS

If well telescopes please sketch and show depths.

GROUND LEVEL

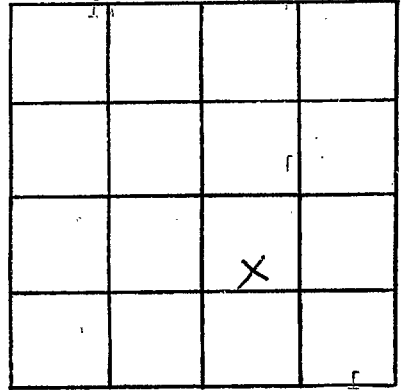

SECTION 36

Please indicate well location X.

ADDITIONAL INFORMATION

If more than one screen,  
show locations of each on sketch.