

LINCOLN  
C9  
5-4-72

MISSISSIPPI  
BOARD OF WATER COMMISSIONERS  
416 North State Street  
Jackson, Mississippi 39201

WATER WELL DRILLERS LOG

**CODED**

May 4 1972 Chester Beene Lincoln  
date well completed firm name county well located

LANDOWNER Dona Spill  
RFD Brookhaven

description of formations encountered	from	to
<u>red sandy clay</u>	<u>0</u>	<u>12</u>
<u>red sand</u>	<u>12</u>	<u>48</u>
<u>sand gravel</u>	<u>48</u>	<u>55</u>

(mailing address)

WELL LOCATION:  
sec 34 T 5N R 7E  
4 miles SW Brookhaven  
(distance) (direction) (nearest town)

WELL PURPOSE: Land  
(home, irrigation, municipal, industrial)

WELL COMPLETION DATA:

- (1) diameter (inches) 4"
- (2) total depth (feet) 55
- (3) static water level (feet) 40 below top of ground.
- (4) casing Plast bottom  
(material) (depth)
- \_\_\_\_\_ if telescope see back.  
(size)
- (5) screen 6' 49'  
(length) (depth to top)
- 4" Plast  
(size) (material)
- (6) pump split 10  
(HP) (yield gpm)
- elect  
(type power)
- (7) electric log no  
(yes or no)

**CODED**

(organization running log)

(8) how well bottom plugged wooden plug


DRILLERS REMARKS:  
new location

MAY 22 1972

DRILLER'S NAME  
WELLER NUMBER

If well telescopes please sketch and show depths.

GROUND LEVEL

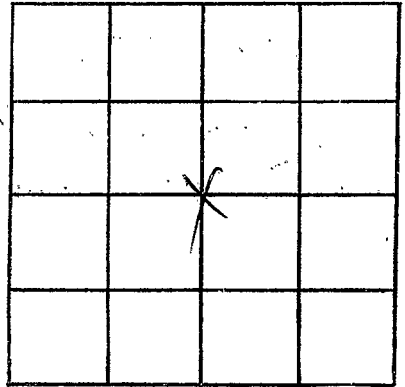

SECTION 34

Please indicate well location X.

ADDITIONAL INFORMATION

If more than one screen, show locations of each on sketch.