

C 10  
 LINCOLN  
 6-28-73

MISSISSIPPI  
 BOARD OF WATER COMMISSIONERS  
 416 North State Street  
 Jackson, Mississippi 39201

CODED

WATER WELL DRILLERS LOG


6-28 1973 Fitzmaurice Inc Lincoln  
 date well completed firm name county well located

LANDOWNER:	description of formations encountered	from	to
<u>Mr. Thornhill</u>			
<u>P.O. Box Brookman, Miss</u> (mailing address)	<u>Red Clay</u>	<u>0</u>	<u>20</u>
	<u>Red Shell</u>	<u>20</u>	<u>135</u>
	<u>Red Clay</u>	<u>135</u>	<u>150</u>
	<u>Coarse Sand</u>	<u>150</u>	<u>164</u>
WELL LOCATION: sec <u>13</u> T <u>20</u> N R <u>7</u> E S W			
<u>14</u> miles <u>N</u> of <u>Brookman</u> (distance) (direction) (nearest town)			
WELL PURPOSE: <u>Home, Pool, Yard</u> (home, irrigation, municipal, industrial)			
WELL COMPLETION DATA:			
(1) diameter (inches) <u>4</u>			
(2) total depth (feet) <u>164</u>			
(3) static water level (feet) <u>60</u> below top of ground. above			
(4) casing <u>plastic, 156</u> (material) (depth)			
<u>4</u> (size) if telescope see back.			
(5) screen <u>8</u> , <u>156</u> (length) (depth to top)			
<u>4</u> , <u>plastic</u> (size) (material)			
(6) pump <u>1 1/2</u> , <u>25</u> (HP) (yield gpm)			
<u>600</u> (type power)			
(7) electric log <u>Y</u> (yes or no)			
<u>W</u> (organization running log)			
(8) how well bottom plugged <u>wood peg</u>			
DRILLERS REMARKS:			

AUG 15 1973

If well telescopes please sketch and show depths.

GROUND LEVEL

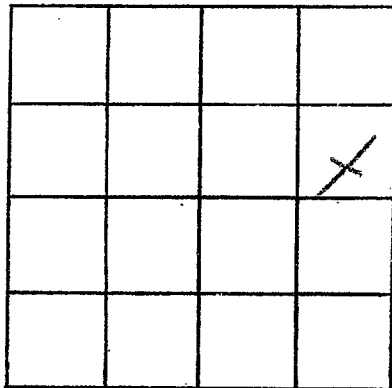

SECTION 13

Please indicate well location X.

ADDITIONAL INFORMATION

If more than one screen, show locations of each on sketch.