

**LINCOLN**  
**CII**  
**1-23-74**  
**Leaf 101**

**MISSISSIPPI**  
**BOARD OF WATER COMMISSIONERS**  
 416 North State Street  
 Jackson, Mississippi 39201

**CODED**

**WATER WELL DRILLERS LOG**

1-23  
 date well completed

1974 Singer-Lewis Central Div.  
 firm name

Lincoln  
 county well located

LANDOWNER: Lincoln Rural  
Water Association  
Shookhaven, Miss.  
 (mailing address)

WELL LOCATION:  
 sec. 7 T. 8 N. R. 7 E.  
 (distance) miles (direction) of (nearest town)

WELL PURPOSE: Domestic  
 (home, irrigation, municipal, industrial)

- WELL COMPLETION DATA:
- (1) diameter (inches) 12"
  - (2) total depth (feet) 612'
  - (3) static water level (feet) 158' below above top of ground.
  - (4) casing Steel, 540',  
 (material) (depth)  
12" if telescope see back.  
 (size) 60' 8 8"
  - (5) screen 60', 540'  
 (length) (depth to top)  
8", S.S. Wire wrapped  
 (size) (material)
  - (6) pump 50 500  
 (HP) (yield gpm)  
Electric  
 (type power)
  - (7) electric log Yes  
 (yes or no)  
Miss. Geo. Survey  
 (organization running log)
  - (8) how well bottom plugged Valve

description of formations encountered	from	to
<u>Red Sand and Gravel</u>	<u>0</u>	<u>36</u>
<u>Yellow Clay</u>	<u>36</u>	<u>50</u>
<u>Blue Clay</u>	<u>50</u>	<u>113</u>
<u>Sandy Clay</u>	<u>113</u>	<u>169</u>
<u>Clay</u>	<u>169</u>	<u>226</u>
<u>Sandy Clay</u>	<u>226</u>	<u>308</u>
<u>Clay</u>	<u>308</u>	<u>375</u>
<u>Sand</u>	<u>375</u>	<u>388</u>
<u>Clay</u>	<u>388</u>	<u>445</u>
<u>Sand</u>	<u>445</u>	<u>468</u>
<u>Clay and Sandy Shales</u>	<u>468</u>	<u>513</u>
<u>Sand</u>	<u>513</u>	<u>604</u>
<u>Shale</u>	<u>604</u>	<u>622</u>


**MISSISSIPPI**  
**BOARD OF WATER COMMISSIONERS**  
**CODED**  
**FEB 28 1974**  
**MISSISSIPPI**

DRILLERS REMARKS:

2

If well telescopes please sketch and show depths.

GROUND LEVEL

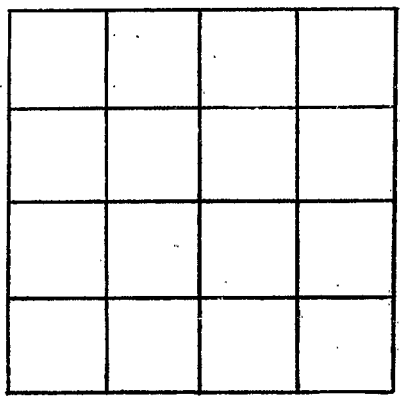

SECTION \_\_\_\_\_

Please indicate well location X.

ADDITIONAL INFORMATION

Lined area for additional information.

If more than one screen, show locations of each on sketch.