

LINCOLN

C-12

6-7-73

MISSISSIPPI BOARD OF WATER COMMISSIONERS
416 North State Street
Jackson, Mississippi 39201

CODED

WATER WELL DRILLERS LOG

June 7 1973
date well completed

Chester Keener
firm name

Lincoln
county well located

LANDOWNER: Vernie Henderson
R.D. Brookhaver
(mailing address)

description of formations encountered	from	to
clay	0	16
red sand	16	55
cross sand	55	62
sand block	62	62
wt. white clay	62	117
fine white sand	117	262

WELL LOCATION:
sec. 29 T 4 N R 7 E
6 miles NE Brookhaver
(distance) (direction) (nearest town)

WELL PURPOSE: Home
(home, irrigation, municipal, industrial)

WELL COMPLETION DATA:

- (1) diameter (inches) 4 1/2
- (2) total depth (feet) 262'
- (3) static water level (feet) 157 below above top of ground
- (4) casing Black bottom
(material) (depth)
- (size) if telescope see back.
- (5) screen 6' 256'
(length) (depth to top)
- 4" Plast
(size) (material)
- (6) pump 3/4 Sub 12
(HP) (yield gpm)
- split
(type power)
- (7) electric log NO
(yes or no)

CODED

(organization running log)


(8) how well bottom plugged
wood plug

DRILLERS REMARKS:
New house

REGISTERED
MAY 24 1974

If well telescopes please sketch and show depths.

GROUND LEVEL

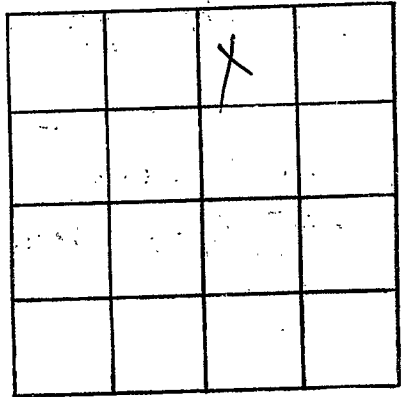

SECTION 29

Please indicate well location X.

ADDITIONAL INFORMATION

If more than one screen, show locations of each on sketch.