

Lincoln
 C13
 9-9-74

MISSISSIPPI
 BOARD OF WATER COMMISSIONERS
 416 North State Street
 Jackson, Mississippi 39201

WATER WELL DRILLERS LOG CODED


Sept. 4 19 74 Brenn Water Well Lincoln
 date well completed firm name county well located

LANDOWNER: Arthur Henderson	description of formations encountered	from	to
Route 1			
Wesson, Miss. (mailing address)			
WELL LOCATION: sec. 36 T 8 N R 7 E 4 miles NW of Brookhaven (distance) (direction) (nearest town)			
WELL PURPOSE: home (home, irrigation, municipal, industrial)			
WELL COMPLETION DATA:			
(1) diameter (inches) 6"			
(2) total depth (feet) 106			
(3) static water level (feet) 60 below top of ground.			
(4) casing EVC 100 (material) (depth) 4" if telescope see back. (size)			
(5) screen 6' 100 (length) (depth to top) .010 PVC (size) (material)			
(6) pump did not install (HP) (yield gpm)			
(type power)			
(7) electric log no (yes or no)			
(organization running log)			
(8) how well bottom plugged wood			
DRILLERS REMARKS:			

RECEIVED
 MISSISSIPPI
 OCT 25 1974

If well telescopes please sketch and show depths.

GROUND LEVEL

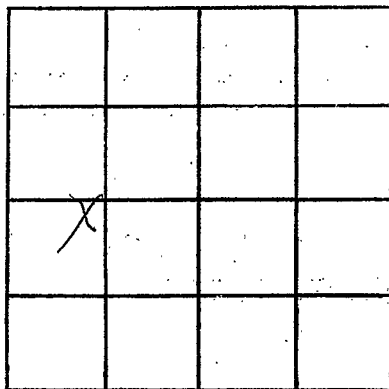

SECTION 36

Please indicate well location X.

ADDITIONAL INFORMATION

If more than one screen, show locations of each on sketch.