

MISSISSIPPI DEPARTMENT OF NATURAL RESOURCES

Bureau of Land and Water Resources

Southport Mall

P.O. Box 10631

Jackson, Mississippi 39209 **CODED**

WATER WELL DRILLERS LOG

Lincoln  
C 48  
9-22-88

9/22 19 88 Morris Bro. Lincoln  
 date well completed firm name county well located

LANDOWNER: Oxy - USA  
P.O. Box 12026  
Jackson, Miss 39234  
 (mailing address)

WELL LOCATION:  
 sec. 23 T. 8 (N) R. 7 (E)  
 S W  
6 miles NE of Brookhaven  
 (distance) (direction) (nearest town)

WELL PURPOSE: Rig Supply  
 (home, irrigation, municipal, industrial)

WELL COMPLETION DATA:

- (1) diameter (inches) 7 7/8
- (2) total depth (feet) 262'
- (3) static water level (feet) \_\_\_\_\_ below above top of ground.
- (4) casing PVC, 243'  
 (material) (depth)  
4" if telescope see back.  
 (size)
- (5) screen 20, 243'  
 (length) (depth to top)  
4", .025 PVC  
 (size) (material)
- (6) pump 5, 60  
 (HP) (yield gpm)  
Electric  
 (type power)
- (7) electric log NO  
 (yes or no)  
 (organization running log)
- (8) how well bottom plugged 4"  
Backwash

description of formations encountered	from	to
Red Clay & Sand	0	20
" " "	20	40
Wash Rock & Sand	40	60
" " "	60	80
Sandy Clay	80	120
Clay	120	220
Sand-Med 10' coarse white	220	240
Sand-Med & Clay	240	262

# 1 ALLEN "A"  
352' N & 184' E of SW/CoR



OCT 12 1988

Department of Natural Resources  
 Bureau of Land & Water Resources

DRILLERS REMARKS:


If well telescopes please sketch and show depths.

GROUND LEVEL

243'

20'

If more than one screen, show locations of each on sketch.

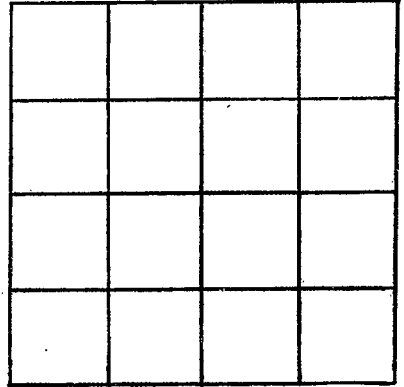

SECTION \_\_\_\_\_

Please indicate well location X.

ADDITIONAL INFORMATION

Multiple horizontal lines for providing additional information.