

MISSISSIPPI DEPARTMENT OF NATURAL RESOURCES

Bureau of Land and Water Resources

P.O. Box 10631

Jackson, Mississippi 39209

WATER WELL DRILLERS LOG

COUNTY WELL LOCATED <i>Lincoln</i>	
WELL NUMBER <i>C51</i>	CODED
DATE WELL COMPLETED <i>9/2/89</i>	

PERMIT NUMBER
NAME OF DRILLING FIRM <i>Easley's Water Well</i>
<i>Brookhaven, MS.</i>

NAME & MAILING ADDRESS OF LANDOWNER <i>Mr. Lemings</i>	
---	--

WELL LOCATION:	SEC	TOWNSHIP	RANGE
<i>Lincoln</i>	<i>5</i>	<i>8 N S</i>	<i>7 E W</i>

DISTANCE	DIRECTION	NEAREST TOWN
<i>4</i> Miles	<i>NE</i>	of <i>Brookhaven</i>

OTHER LANDMARK <i>2 miles driver's store</i>
WELL PURPOSE: Home, Irrigation, Municipal, Industrial, Fish Pond, etc. <i>Home</i>

WELL DATA		
Well Depth <i>115 ft.</i>	Casing Diameter (In.) <i>4 in.</i>	Casing Length (Ft.) <i>95 ft.</i>
Type of Casing <i>PVC #10</i>	Hole Depth <i>115 ft.</i>	Depth to Static Water Level
TYPE OF COMPLETION: (Circle One or More): <input checked="" type="checkbox"/> Gravel Packed, <input type="checkbox"/> Underreamed, <input type="checkbox"/> Telescoped, <input checked="" type="checkbox"/> Natural Development, <input type="checkbox"/> Open Hole, <input type="checkbox"/> Other (Describe) _____ Top of Lap Pipe or Reduction in Casing FEET IF TELESCOPED OR MORE THAN ONE SCREEN: USE BACK PAGE		

SCREEN DATA		
Diameter - Inches <i>4 in.</i>	Length - Feet <i>20 ft.</i>	Slot Size - Inches <i>0.10</i>
Screen Type <i>PVC</i>	Depth to Bottom - Feet <i>115 ft.</i>	

PUMP DATA		
PUMP TYPE (Circle One): <input checked="" type="checkbox"/> Submersible, <input type="checkbox"/> Turbine, <input type="checkbox"/> Jet <input type="checkbox"/> Flowing Well, Other (Describe) _____		
POWER TYPE (Circle One): <input checked="" type="checkbox"/> Electric, <input type="checkbox"/> Tractor, <input type="checkbox"/> Diesel, <input type="checkbox"/> Gasoline, <input type="checkbox"/> Butane, Other (Describe) _____ H/P _____		
Pump Capacity (GPM) <i>10</i>	No. of Stages <i>9</i>	Setting Depth <i>65</i> FT.
PUMP TEST Well yielded _____ GPM with a drawdown of _____ ft. after _____ hours of pumping		

LOG DATA	
TYPE OF LOG RUN (Circle One): <input checked="" type="checkbox"/> No Log Run, <input type="checkbox"/> Electric, <input type="checkbox"/> Gamma Ray, <input type="checkbox"/> Density, <input type="checkbox"/> Sonic, <input type="checkbox"/> Neutron, Other (Describe) _____	
Name of Organization Running Log	

GEOLOGIC DATA (Office Use Only)			
Surface Elev.	Geologic Unit	Unit Thickness	Depth to Top
Subs. SWL	Date	Analysis	Aquifer Test

Driller's Remarks

DESCRIPTION OF FORMATIONS ENCOUNTERED	FROM	TO	FORMATIONS (Continued)	FROM	TO
<i>clay fine white clay good coarse sand</i>	<i>0</i>	<i>20 ft.</i>			
	<i>20 ft.</i>	<i>95 ft.</i>			
	<i>95 ft.</i>	<i>115 ft.</i>			

RECEIVED


APR 16 1990

Department of Natural Resources
Bureau of Land & Water Resources

IF MORE SPACE IS NEEDED, USE BACK

If well telescopes please sketch and show depths.

GROUND LEVEL

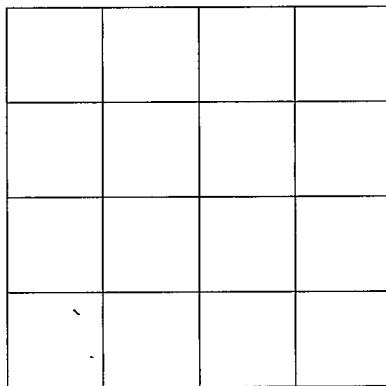

SECTION _____

Please indicate well location X.

ADDITIONAL INFORMATION

If more than one screen,
show location of each on sketch.