

**MISSISSIPPI DEPARTMENT OF NATURAL RESOURCES**  
**Bureau of Land and Water Resources**  
 Southport Mall  
 P.O. Box 10631  
 Jackson, Mississippi 39209  
**WATER WELL DRILLERS LOG**

Lincoln  
C 55


July 16 1984 Grenn Water Well Lincoln  
 date well completed firm name county well located

LANDOWNER: <u>Benjie Smith</u> Rt. 3, Box 639	description of formations encountered	from	to
<u>Brookhamen, Ms.</u> (mailing address)	<u>Citronelle</u>	<u>1</u>	<u>87</u>
WELL LOCATION: sec. <u>33</u> T. <u>8</u> N R. <u>7</u> E S W <u>2</u> miles NW of <u>Brookhaven</u> (distance) (direction) (nearest town)			
WELL PURPOSE: <u>home</u> (home, irrigation, municipal, industrial)			
WELL COMPLETION DATA:			
(1) diameter (inches) <u>4</u>			
(2) total depth (feet) <u>87</u>			
(3) static water level (feet) <u>50</u> below above top of ground.			
(4) casing <u>PVC</u> , <u>77'</u> (material) (depth) <u>4"</u> if telescope see back. (size)			
(5) screen <u>10'</u> , <u>77'</u> (length) (depth to top)			
(6) pump <u>.010</u> , <u>PVC</u> (size) (material)			
(6) pump <u>did not install</u> (HP) (yield gpm)			
(type power)			
(7) electric log <u>no</u> (yes or no)			
(organization running log)			
(8) how well bottom plugged <u>back wash valve</u>			
DRILLERS REMARKS:			

DEPT. OF NATURAL RESOURCES  
 BUREAU OF LAND & WATER RESOURCES  
 SEP 28 1984  
**RECEIVED**

If well telescopes please sketch and show depths.

GROUND LEVEL

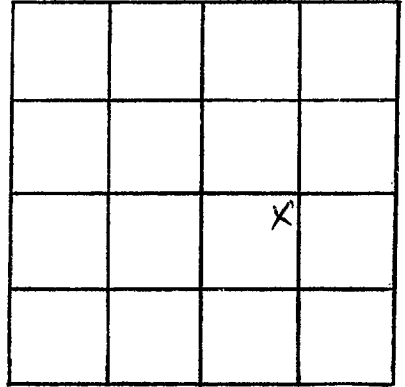

SECTION 33

Please indicate well location X.

ADDITIONAL INFORMATION

If more than one screen,  
show locations of each on sketch.