

Lincoln  
C 60  
3-9-77

MISSISSIPPI  
BOARD OF WATER COMMISSIONERS  
416 North State Street  
1324 Jackson, Mississippi 39201

WATER WELL DRILLERS LOG

March 9 1977 Grenn Water Well Cont. Lincoln

date well completed

firm name

county well located


LANDOWNER:	description of formations encountered	from	to
Neil Lewis Route 2, Box 251 Brookhaven, Miss. (mailing address)	Citronelle	11	106
<b>WELL LOCATION:</b>			
sec. 33 T 8 <u>N</u> S 4 miles Nw of Brookhaven (distance) (direction) (nearest town)	R 7 <u>E</u> W		
<b>WELL PURPOSE:</b> home (home, irrigation, municipal, industrial)			
<b>WELL COMPLETION DATA:</b>			
(1) diameter (inches) 6"			
(2) total depth (feet) 106			
(3) static water level (feet) 46 below top of ground. above			
(4) casing Pvc, 100' (material) (depth) 4" if telescope see back. (size)			
(5) screen 6' 100' (length) (depth to top) .010 PVC (size) (material)			
(6) pump 1/2 Sub 10 (HP) (yield gpm) electricity (type power)			
(7) electric log no (yes or no)  (organization running log)			
(8) how well bottom plugged Back wash valve			
<b>DRILLERS REMARKS:</b>			

RECEIVED  
APR 22 1977

MISSISSIPPI WATER COMMISSION

If well telescopes please sketch and show depths.

GROUND LEVEL

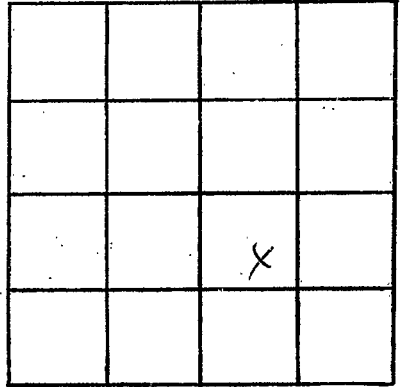

SECTION 33

Please indicate well location X.

ADDITIONAL INFORMATION

If more than one screen, show locations of each on sketch.