

**MISSISSIPPI DEPARTMENT OF ENVIRONMENTAL QUALITY**  
Bureau of Land and Water Resources

P. O. Box 10631  
Jackson, MS 39289-0631  
**WATER WELL DRILLERS LOG**

COUNTY WELL LOCATED <u>Lincoln</u>	
WELL NUMBER <u>C</u>	CODED <u>2002</u>
DATE WELL COMPLETED <u>7-23-04</u>	

PERMIT NUMBER
NAME OF DRILLING FIRM <u>Green Water Well &amp; Supply</u>

NAME & MAILING ADDRESS OF LANDOWNER <u>Joyce Cameron</u>			
<u>P.O. Box 3304</u>			
<u>Brookhaven MS 39601</u>			
WELL LOCATION:	SEC	TOWNSHIP	RANGE
	<u>5</u>	<u>8</u>	<u>7</u>
DISTANCE	DIRECTION	NEAREST TOWN	
<u>7</u> Miles	<u>N</u>	of <u>Brookhaven</u>	
OTHER LANDMARK			
WELL PURPOSE <input checked="" type="checkbox"/> Home Irrigation, Municipal, Industrial, Fish Pond, etc.			

<b>PUMP DATA</b>			
PUMP TYPE (Circle One): <input checked="" type="checkbox"/> Submersible Turbine, Jet Flowing Well, Other (Describe) _____			
POWER TYPE (Circle One): <input checked="" type="checkbox"/> Electric Tractor, Diesel, Gasoline, $\frac{1}{2}$ Butane, Other (Describe) _____ H/P <u>2</u>			
Pump Capacity (GPM)	No. of Stages	Setting Depth	
<u>10</u>	<u>9</u>	<u>76</u> FT.	
PUMP TEST			
Well yielded <u>10</u> GPM with a drawdown of <u>0</u> ft. after <u>1</u> hours of pumping			

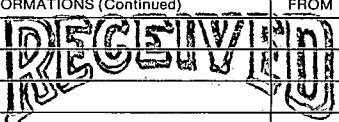
<b>WELL DATA</b>		
Well Depth <u>82 ft.</u>	Casing Diameter (in.) <u>4 in.</u>	Casing Length (Ft.) <u>72 ft.</u>
Type of Casing <u>PVC</u>	Hole Depth	Depth to Static Water Level <u>58</u>
TYPE OF COMPLETION: (Circle One or More): <input checked="" type="checkbox"/> Gravel Packed, Underreamed, Telescoped, Natural Development, Open Hole, Other (Describe) _____		
Top of Lap Pipe or Reduction in Casing		
FEET	IF TELESCOPED OR MORE THAN ONE SCREEN: USE BACK PAGE	

<b>LOG DATA</b>	
TYPE OF LOG RUN (Circle One): Electric, Gamma Ray, Density, Sonic, Neutron, Other (Describe) <input checked="" type="checkbox"/> No Log Run	
Name of Organization Running Log	

<b>SCREEN DATA</b>		
Diameter - Inches <u>4 in.</u>	Length - Feet <u>10 ft.</u>	Slot Size - Inches <u>.010</u>
Screen Type <u>PVC</u>	Depth to Bottom - Feet <u>82 Ft.</u>	

<b>GEOLOGIC DATA (Office Use Only)</b>			
Surface Elev.	Geologic Unit	Unit Thickness	Depth to Top
Subs. SWL	Date	Analysis	Aquifer Test

Driller's Remarks

DESCRIPTION OF FORMATIONS ENCOUNTERED	FROM	TO	FORMATIONS (Continued)	FROM	TO
<u>Red Clay</u>	<u>0</u>	<u>12</u>	 <b>FEB 13 1995</b> Dept. of Environmental Quality Office of Land & Water Resources		
<u>Sandy Clay &amp; Gravel</u>	<u>12</u>	<u>27</u>			
<u>White Clay</u>	<u>27</u>	<u>55</u>			
<u>Sand</u>	<u>55</u>	<u>82</u>			
<u>White Clay</u>	<u>82</u>	<u>86</u>			

IF MORE SPACE IS NEEDED, USE BACK

If well telescopes please  
sketch and show depths.

GROUND LEVEL

			X

SECTION 5

Please indicate well location X.

ADDITIONAL INFORMATION

If more than one screen,  
show location of each on sketch.