

D1

11-2-60

CODED

WATER WELL DRILLERS LOG

~~D-200~~

Date:

Nov 2, 1960

Driller:

E. B. Joreff

County

Lincoln

(Name)

(1) Owner of Land:	Description & Color of Materials Sand, Clay, Red Clay, Shell, etc.	Thick- ness Feet	Depth Feet
W. E. Thompson (Name)	Red Sdg. Clay	0	15
Rt. 3 Brookhaven, Miss (Address)	Gravel	15	20
(2) Location: SW 1/4 N.W. 1/4, Sec. 7 T. 8 R. 8	Clay + Gravel. St. exp	20	30
3 miles West of Wesson (distance) (direction) (Nearest Town)	White Clay	30	48
(3) Topography: Hilly (Hilly) (Flat) (Level)	48-60 White SAND (FINE)	48	60
(4) Purpose of Well: Domestic (Domestic Irrigation Municipal, Industrial, Other)	White Clay	60	75

Information upon completion of well:


- (1) Diameter 6 1/2 inches.
- (2) Total Depth 100' feet.
- (3) Water Level _____ feet below top of ground.
- (4) Cased to 100', Size 4"
- (5) Screen: Size _____, Length _____
- (6) Were any formations sealed against pollution?
_____ yes, No no.

CODED

If YES depth of formation _____

Why _____

Drillers Remarks: _____

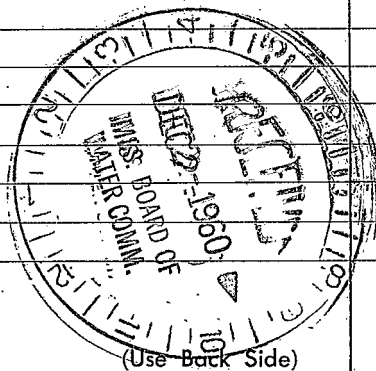

221.45

Well No.

Handwritten text at the top of the page, possibly a title or header.

Handwritten text in the upper middle section.

Handwritten text in the middle section, appearing as a list or series of entries.

Handwritten text in the middle section, continuing the list or entries.

Handwritten text in the middle section, continuing the list or entries.

Handwritten text in the middle section, continuing the list or entries.

Handwritten text in the lower middle section.

Small handwritten mark or symbol.

Small handwritten mark or symbol.

Small handwritten mark or symbol.

Small handwritten mark or symbol.