

LINCOLN MISSISSIPPI BOARD OF WATER COMMISSIONERS

D2

D-301

9-9-60 CODED WATER WELL DRILLERS LOG

Date: 9-9, 1960, Driller: Charles Reeves County Lincoln

(Name)

(1) Owner of Land: Rev. H.P. Potter
(Name)
RFD - Brookhaven
(Address)

(2) Location: 1/4, 1/4, Sec. 35 T8R8
6 miles N.E. of Brookhaven
(distance) (direction) (Nearest Town)

(3) Topography: Hilly
(Hilly) (Flat) (Level)

(4) Purpose of Well: Domestic
(Domestic Irrigation Municipal, Industrial, Other)

Description & Color of Materials Sand, Clay, Red Clay, Shell, etc.	Thick- ness Feet	Depth Feet
Clay	10	10
yellow sand	15	25
wh. to chalk	10	35
wh. to sand	5	40
chalk	45	85
white coarse sand	6	91

Information upon completion of well:

(1) Diameter: 2 inches.

(2) Total Depth: 91 feet.


(3) Water Level: 40 feet below top of ground.

(4) Cased to Bottom, Size 2"

(5) Screen: Size 1 1/4, Length 6'

(6) Were any formations sealed against pollution?
 _____ yes, no.

CODED

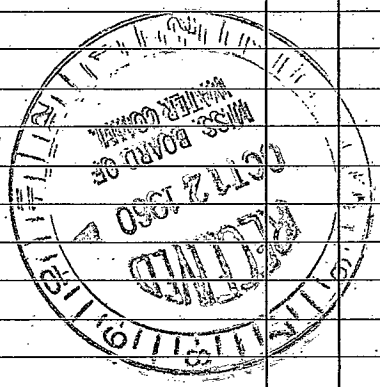

If YES depth of formation _____
 Why _____

Drillers Remarks: _____

(Use Back Side)

Well No.

