

D3

9-14-65 CODED WATER WELL DRILLERS LOG

Date: 9-14, 1965, Driller: Chert. Lewis County: Lincoln
(Name)

(1) Owner of Land: Claude Day
(Name)
RFL, Wesson
(Address)

(2) Location: 1/4, 1/4, Sec. 24 T. 38 R. 1
5 miles N/E of Brookhaven
(distance) (direction) (Nearest Town)

(3) Topography: Hilly
(Hilly) (Flat) (Level)

(4) Purpose of Well: Domestic
(Domestic Irrigation
Municipal, Industrial, Other)

Description & Color of Materials Sand, Clay, Red Clay, Shell, etc.	Thick- ness Feet	Depth Feet
<u>Top of sand</u>	<u>10</u>	<u>10</u>
<u>Yellow sand</u>	<u>23</u>	<u>33</u>
<u>Blue chalk</u>	<u>206</u>	<u>239</u>
<u>white sand</u>	<u>30</u>	<u>269</u>

Information upon completion of well:

(1) Diameter 4 inches.

(2) Total Depth 269 feet.

(3) Water Level 140 feet below top of ground.

(4) Cased to bottom Size 4"

(5) Screen: Size 4", Length 7'


(6) Were any formations sealed against pollution?
_____ yes, X no.

CODED

If YES depth of formation _____

Why _____

Drillers Remarks: and prepared
hole to get
shallow well

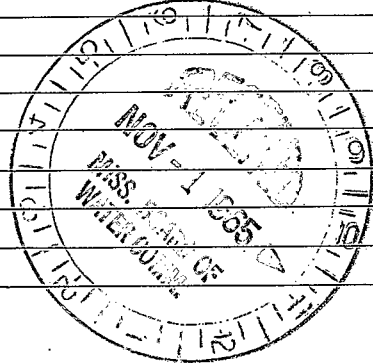

(Use Back Side)

Well No.

1870

1871

1872

1900