

Lincala
 D4
 8-67
 CODED

MISSISSIPPI
 BOARD OF WATER COMMISSIONERS
 416 North State Street
 Jackson, Mississippi 39201

WATER WELL DRILLERS LOG

8-14-19 *1967 Fitzgerald Water Well* *Linedale*
 date well completed firm name county well located

LANDOWNER: *Bumell Brown*
Brookhaven Miss
RT6 Box 80
 (mailing address)

description of formations encountered	from	to
<i>White Sand & gravel</i>	<i>0</i>	<i>50</i>
<i>Chalk</i>	<i>50</i>	<i>85</i>
<i>Fine Sand</i>	<i>85</i>	<i>98</i>
<i>Medium Sand</i>	<i>98</i>	<i>110</i>
<i>Coarse Sand & gravel</i>	<i>110</i>	<i>118</i>


WELL LOCATION:
 sec *2* T *8* N R *8* E
8 miles *N* of *Brookhaven*
 (distance) (direction) (nearest town)

WELL PURPOSE: *house*
 (home, irrigation, municipal, industrial)

- WELL COMPLETION DATA:
- (1) diameter (inches) *4*
 - (2) total depth (feet) *118*
 - (3) static water level (feet) *80* below/above top of ground.
 - (4) casing *plastic 1 1/2*
 (material) (depth)
 - 4* if telescope see back.
 (size)
 - (5) screen *61* *112*
 (length) (depth to top)
 - of plastic*
 (size) (material)
 - (6) pump *2* *2*
 (HP) (yield gpm)
 - (type power)
 - (7) electric log *no*
 (yes or no)
 - (organization running log)
 - (8) how well bottom plugged *Wood peg*

Chalk *118*


CODED

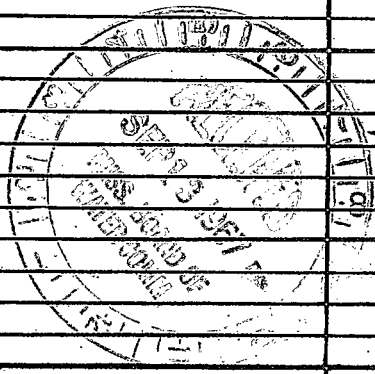

DRILLERS REMARKS:

If well telescopes please sketch and show depths.

GROUND LEVEL

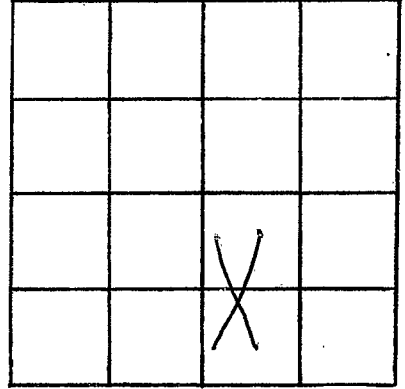

SECTION 21

Please indicate well location X.

ADDITIONAL INFORMATION

Lined area for additional information, containing a small hand-drawn sketch of a well profile.

If more than one screen, show locations of each on sketch.