

Lined
D5
11-67

MISSISSIPPI
 BOARD OF WATER COMMISSIONERS
 416 North State Street
 Jackson, Mississippi 39201

CODED

WATER WELL DRILLERS LOG

11-20 19 *67* *Fitzgerald Water Well Co.* *Lined*
 date well completed firm name county well located

LANDOWNER: *Grady Tarver*
R. J. Messon MISS

(mailing address)

WELL LOCATION:
 sec. *28* T. *8* N. *8* E. *W*
S miles *5* (distance) *N* (direction) of *Bruckhaven* (nearest town)

WELL PURPOSE: *home*
 (home, irrigation, municipal, industrial)

WELL COMPLETION DATA:

- (1) diameter (inches) *4*
- (2) total depth (feet) *76*
- (3) static water level (feet) *30* below/above top of ground.
- (4) casing *plastic*, *55* (material) (depth)
4 (size) if telescope see back.
- (5) screen *6'*, *55* (length) (depth to top)
4, *plastic* (size) (material)
- (6) pump *—* (HP) *—* (yield gpm)
Elec (type power)
- (7) electric log *NO* (yes or no)

(organization running log)


(8) how well bottom plugged *Wind plug*

description of formations encountered

from to

<i>top soil to clay</i>	<i>0</i>	<i>10</i>
<i>gravel + sand</i>	<i>10</i>	<i>35</i>
<i>Rock</i>	<i>35</i>	<i>40</i>
<i>gravel + (Weniso) Sand</i>	<i>40</i>	<i>61</i>
<i>Chalk</i>	<i>61</i>	

CODED

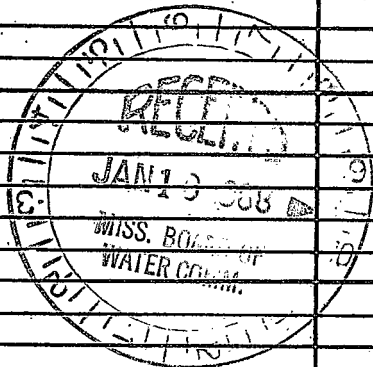

DRILLERS REMARKS:

If well telescopes please sketch and show depths.

GROUND LEVEL

X			

SECTION 28

Please indicate well location X.

ADDITIONAL INFORMATION

If more than one screen, show locations of each on sketch.