

LINCOLN
D9
9-3-70

MISSISSIPPI
BOARD OF WATER COMMISSIONERS
416 North State Street
Jackson, Mississippi 39201

CODED

WATER WELL DRILLERS LOG

Sept 3 1970 Chester Keenes Licoles
date well completed firm name county well located

LANDOWNER: Thomas
Larry Dickerson
RFD Brookhaven
(mailing address)

WELL LOCATION:
sec. 36 T. 8 N. R. 5 E
5 miles NE Brookhaven
(distance) (direction) (nearest town)

WELL PURPOSE: House
(home, irrigation, municipal, industrial)

WELL COMPLETION DATA:

(1) diameter (inches) 4"

(2) total depth (feet) 132

(3) static water level (feet) 50 below top of ground.

(4) casing Plastic Bottom
(material) (depth)

(size) if telescope see back.

(5) screen 6' 126'
(length) (depth to top)

4" Plastic
(size) (material)

(6) pump run by counts
(HP) (yield gpm)

(type power)

(7) electric log (yes or no)

(organization running log)

description of formations encountered	from to	
<u>Clay & gravel</u>	<u>0</u>	<u>18</u>
<u>Gravel & Sand</u>	<u>18</u>	<u>67</u>
<u>Sandy Sandy</u>	<u>67</u>	<u>120</u>
<u>chick</u>		
<u>Coarse Sand</u>	<u>120</u>	<u>132</u>

CODED

(8) how well bottom plugged wooden plug


DRILLERS REMARKS: old well
dry

OCT 14 1970

MISS. BD. OF
WATER COMM.

If well telescopes please sketch and show depths.

GROUND LEVEL

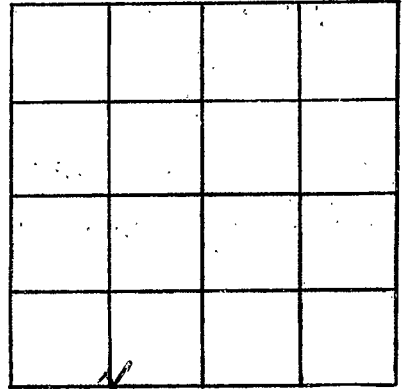

SECTION 36

Please indicate well location X.

ADDITIONAL INFORMATION

If more than one screen,
show locations of each on sketch.