

LINCOLN  
D 10  
9-21-73

MISSISSIPPI  
BOARD OF WATER COMMISSIONERS  
416 North State Street  
Jackson, Mississippi 39201

CODED

WATER WELL DRILLERS LOG

Sept 21 1973 Greenwater Well Co. Lincoln  
date well completed firm name county well located

LANDOWNER: C.B. Meak  
W. Congress St.  
Brookhaven, Miss.  
(mailing address)

description of formations encountered	from	to
Citronelle	0	125

WELL LOCATION:  
sec. 32 T. 8 N R. 8 E  
1 miles N of Brookhaven  
(distance) (direction) (nearest town)

WELL PURPOSE: Home  
(home, irrigation, municipal, industrial)

WELL COMPLETION DATA:

(1) diameter (inches) 6"

(2) total depth (feet) 106

(3) static water level (feet) 68 below above top of ground.

(4) casing PVC, 100 (material) (depth)  
4" (size) If telescope see back.

(5) screen 6' 100 (length) (depth to top)  
010 PVC (size) (material)

(6) pump 1/2 HP 7 (HP) (yield gpm)  
electricity (type power)

(7) electric log No (yes or no)

(organization running log)

(8) how well bottom plugged wood

CODED


DRILLERS REMARKS:

NOV 25 1973

MISS. BD. OF  
WATER COM.

If well telescopes please sketch and show depths.

GROUND LEVEL

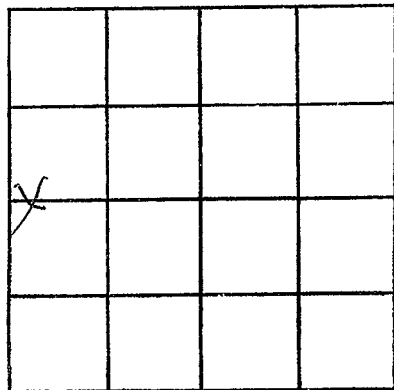

SECTION 32

Please indicate well location X.

ADDITIONAL INFORMATION

If more than one screen,  
show locations of each on sketch.