

**State Well Report
Part 1 – Driller's Log**

Mississippi Department of Environmental Quality
Office of Land and Water Resources
P.O. Box 10631
Jackson, MS 39289-0631
(601)961-5210
(601)354-6938 (fax)

County: Lincoln
 Permit #: _____
 Driller: LARRY ENLEY
 Date drilling completed: 9-14-06

For Office Use Only:

Aquifer: _____
 Well #: D-27
 L. S. Elevation: _____
 E-log #: _____

State Law requires that this report be prepared by the license holder responsible for the work and filed with the Department at the above address within 30 days of completion of drilling of the well or borehole.

Information on Well Owner <i>(Landowner if borehole is not for a water well)</i>	Well or Borehole Location
Owner Name: <u>Adam Calcote</u>	Latitude: <u>31° 37' 03"</u> Longitude: <u>90° 22' 48"</u>
Mailing Address: <u>774 Clark Travis Rd</u>	Method of Lat/Long (circle one): Conventional Survey, _____ USGS quad, Hand-held GPS, Survey-grade GPS _____
City: <u>Brookhaven MS</u> State: <u>MS</u> Zip Code: <u>39601</u>	NE $\frac{1}{4}$ SE $\frac{1}{4}$ Sec. <u>34</u> Twn <u>8N</u> Rng <u>8E</u>
Telephone No. (_____) _____	Distance: <u>4</u> Miles Direction: <u>NE</u> of Nearest Town: <u>Brookhaven</u>

Well / Borehole Data

Date drilling started: 9-14 Date drilling completed: 9-14 Hole depth: 180 Hole diameter: 7 7/8

Location of the source of any surface water used for drilling: creek

Method of dosing and volume of Chlorine used in drilling and development: 1 gal to every 3000

Logs run (circle all applicable): ~~No log run~~ Electric Gamma Ray Density Sonic Neutron Other: _____

Name of organization running log(s): _____

Purpose of borehole (check one): Water Well Geotechnical/Geological Investigation _____ Ground Source Heat Pump _____

Seismic Survey _____ Other (describe) _____

If drilling is not related to water well construction, skip the remainder of this block

Purpose of Well (check one): Home Industrial _____ Public Supply _____ Irrigation _____ Fish Culture _____ Other: _____

If a flowing well, method of flow regulation: Valve _____ Other (describe) _____

Static Water Level: 70 feet above or below (circle one) land surface Date measured: 9-14-06

Method of Measurement (circle one): level tape electric tape air line other: _____

Well depth: 150 Well grouted to a depth of 10 feet Type of grout (circle one): Neat Cement Bentonite Mix

Casing length: 130 feet Casing diameter: 4 inches Type of casing: PVC

Screen length: 20 feet Screen diameter: 4 inches Type of screen: PVC

Screen slot size: 010 inches Setting depth: From 130 feet to 150 feet


Type of completion (circle all applicable): Gravel packed _____ Underreamed _____ Telescoped _____ Open hole _____ Natural Development

Other (describe): _____

Top of lap pipe or reduction in casing: _____ feet. If telescoped or more than one screen, describe in text notes.

RECEIVED
 For OLWR/SW/MSA
 NOV 27 2006
BY: OLWR

If well telescopes please sketch below and show depths

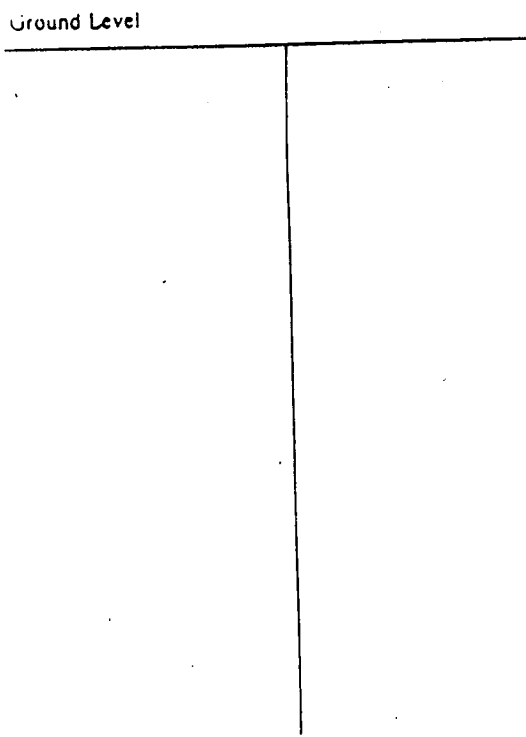

Description of Formations Encountered	From	
Clay	0	50
Sand	50	70
Clay	70	130
Sand	130	150
Clay	150	180

If more than one screen, show location of each on sketch

Sketch the property layout and include the following: 1) the well location; 2) any permanent structures on the property that may aid in locating the well, 3) any roads, power lines, or other items that may aid in locating the property and the well; 4) indicate direction

Landowner Name: Adam Calcote

Larry E. J.
Signature of Water Well Contractor

RECEIVED
NOV 27 2006
BY: OLWR

STATE WELL REPORT

Part 2

Pump Installer's Completion Report
 Mississippi Department of Environmental Quality
 Office of Land and Water Resources
 P.O. Box 10631
 Jackson, MS 39289-0631
 (601)961-5210
 (601)354-6938 (fax)

County: Lincoln
 Permit #: _____
 Driller: LARRY EASLEY
 Date completed: 9-14-06
Copy information from block on Part 1

For Office Use Only:

Aquifer: _____
 Well #: D-27
 Elevation: _____

This part of the report must be completed by a licensed water well contractor or a licensed pump installer. A copy of Part 1 of the report must be attached and both parts filed with the Department at the above address within 30 days of well completion.

Well Owner Information	Well Location
Owner Name: <u>Adam Calcote</u>	Latitude: _____ Longitude: _____
Mailing Address: _____	Method of Lat/Long (check one): Conventional Survey _____
_____	USGS quad _____, Hand-held GPS _____, Survey-grade GPS _____
_____	_____ 1/4 _____ 1/4 Sec <u>34</u> T <u>8N</u> R <u>8E</u>
City _____ State _____ Zip Code _____	Distance _____ Direction _____ Nearest Town _____
Telephone No. (____) _____	_____ Miles _____ of _____

Pump Type Circle one	Power Type Circle one
Air Lift Jet <u>Submersible</u>	Diesel Engine Gasoline Engine Natural Gas
Bucket Piston Turbine	<u>Electric Motor</u> Hand Tractor PTO
Centrifugal Rotary Flowing Well	Windmill Other (specify): _____
Other (specify): _____	Horse Power Rating of Motor: <u>1</u>
Date Pump Installed: <u>9-14-06</u>	Setting Depth: <u>100</u> feet
Rated Pump Capacity: <u>12</u> Gallons Per Minute	Number of Stages: <u>12</u>

Pump Test Data	Method of Measuring Water Level Circle one
Date Well Tested: <u>9-14-06</u>	Air Line Electric Measuring Line <u>Susel Tape</u>
Static Water Level (A): <u>70</u> Feet Below Land Surface	Other (specify): _____
Pumping Water Level (B): <u>80</u> Feet Below Land Surface	For flowing well, measured shut in head: _____ feet
Drawdown [(B) - (A)]: <u>10</u> Feet Below Land Surface	Well yielded <u>12</u> GPM with a drawdown of
Test Pumping Rate: <u>12</u> Gallons Per Minute	<u>10</u> feet after <u>4</u> hours of pumping
Duration of Pump Test (minimum 4 hours): <u>4</u> hours	

I HEREBY CERTIFY that the above statements are true to the best of my knowledge.

LARRY EASLEY 510 Larry Easley
 Print Name of Pump Installer and License No. (if applicable) Signature of Pump Installer

RECEIVED
 Form OLWR-1B
 NOV 27 2006
BY: OLWR