

LINCOLN
D 2000
9-28-77

MISSISSIPPI
BOARD OF WATER COMMISSIONERS
416 North State Street
Jackson, Mississippi 39201

MISSISSIPPI
BOARD OF WATER COMMISSIONERS
416 North State Street
Jackson, Mississippi 39201

WATER WELL DRILLERS LOG

Sept. 28 19 87 Green Water Well Cont. Lincoln
date well completed firm name county well located

LANDOWNER: Jim Hutchins
Route 1, Box 39
Brookhaven, Miss.
(mailing address)

description of formations encountered	feet	
	from	to
<u>Citronelle</u>	<u>1</u>	<u>59</u>

WELL LOCATION:
sec. 23 T. 8 S. R. 8 E
7 miles NE of Brookhaven
(distance) (direction) (nearest town)

WELL PURPOSE: home
(home, irrigation, municipal, industrial)

- WELL COMPLETION DATA:
- (1) diameter (inches) 6
 - (2) total depth (feet) 59
 - (3) static water level (feet) 46 below top of ground.
 - (4) casing PVC 47'
(material) (depth)
4" if telescope see back.
(size)
 - (5) screen 12' 47'
(length) (depth to top)
010 PVC
(size) (material)
 - (6) pump 1/2 sub 10
(HP) (yield gpm)
electricity
(type power)
 - (7) electric log no
(yes or no)
(organization running log)
 - (8) how well bottom plugged back wash valve


RECEIVED
OCT 26 1977

DRILLERS REMARKS:

REMARKS: MISS. BO. OF WATER COMMISSIONERS

If well telescopes please sketch and show depths.

GROUND LEVEL

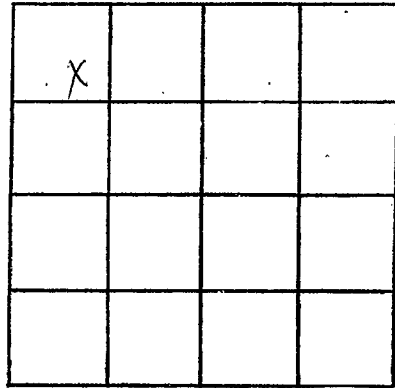

SECTION 23

Please indicate well location X.

ADDITIONAL INFORMATION

If more than one screen, show locations of each on sketch.