

LINCOLN
D 2001
2/27/78

**MISSISSIPPI
BOARD OF WATER COMMISSIONERS**
416 North State Street
Jackson, Mississippi 39201

WATER WELL DRILLERS LOG

2-27 1978 Grenn Water Well Cont. Lincoln
 date well completed firm name county well located

LANDOWNER: Leroy Poole
P.O. Box 111
Brookhaven, Miss.
 (mailing address)

description of formations encountered	from	to
Citronelle	1	87

WELL LOCATION:
 sec. 31 T. 8 N. R. 8 E
 S. W.
1 miles N of Brookhaven
 (distance) (direction) (nearest town)

WELL PURPOSE: home
 (home, irrigation, municipal, industrial)

WELL COMPLETION DATA:

(1) diameter (inches) 6"

(2) total depth (feet) 87'

(3) static water level (feet) 57 below top of ground.

(4) casing PVC 75'
 (material) (depth)
4"
 (size) if telescope see back.

(5) screen 12" 75
 (length) (depth to top)
.010 PVC
 (size) (material)

(6) pump 1/2 HP sub 10
 (HP) (yield gpm)

electricity
 (type power)

(7) electric log no
 (yes or no)

(organization running log)

(8) how well bottom plugged back wash valve


DRILLERS REMARKS:

RECEIVED
 APR 17 1978

MISS. Bd. OF WATER COMMISSIONERS

If well telescopes please sketch and show depths.

GROUND LEVEL

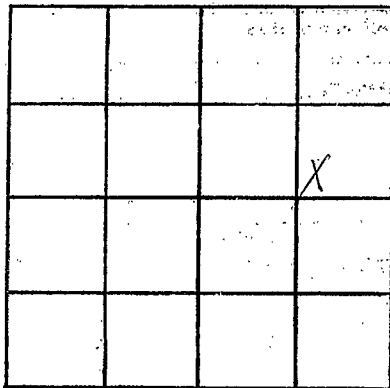

SECTION 31

Please indicate well location X.

ADDITIONAL INFORMATION

If more than one screen, show locations of each on sketch.