

LINCOLN
D
6/21/78
2002

**MISSISSIPPI
BOARD OF WATER COMMISSIONERS**
416 North State Street
Jackson, Mississippi 39201

WATER WELL DRILLERS LOG

June 21, 1978 78 Gremm Water Well Contr. Lincoln
 date well completed firm name county well located

LANDOWNER: Charles R. Hart
 P.O. Box 336
 Wesson, Miss.
 (mailing address)

description of formations encountered	from	to
Citronelle	1	88

WELL LOCATION:
 sec. 17 T 8 N R 8 E
 2 S W Wesson, Miss.
 (distance) (direction) (nearest town)

WELL PURPOSE: home
 (home, irrigation, municipal, industrial)

WELL COMPLETION DATA:

(1) diameter (inches) 6

(2) total depth (feet) 88

(3) static water level (feet) 50 below top of ground.

(4) casing PVC 82';
 4" (material) (depth)
 (size) if telescope see back.


(5) screen 6' 82'
 .010 (length) PVC (depth to top) (material)

(6) pump 1/2 HP sub 10
 (HP) (yield gpm)
 electricity
 (type power)

(7) electric log no
 (yes or no)
 (organization running log)

(8) how well bottom plugged back wash valve


DRILLERS REMARKS:

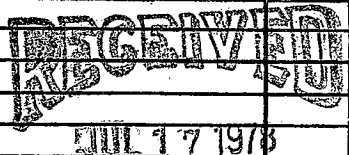

MISS. BD. OF WATER COMM

If well telescopes please sketch and show depths.

GROUND LEVEL

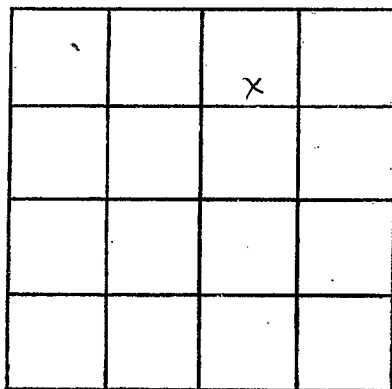

SECTION 17

Please indicate well location X.

ADDITIONAL INFORMATION

If more than one screen,
show locations of each on sketch.